


WATER WELL RECORD Form WWC-5 KSA 82a-1212

1 LOCATION OF WATER WELL: Fraction Section Number Township Number Range Number
 COUNTY: EDWARDS NE 1/4 NE 1/4 NE 1/4 4 T 24 S R 19 W

Distance and direction from nearest town or city street address of well if located within city?
 5 MILES NORTH OF KINSLEY

2 WATER WELL OWNER: HABIGER, MICHAEL Board of Agriculture, Division of Water Resources
 RR#, St. Address, Box # : 711 E. 8TH ST.
 City, State, ZIP code : KINSLEY, KS 67547- Application Number:

3 LOCATE WELL'S LOCATION WITH AN "X" IN SECTION BOX:

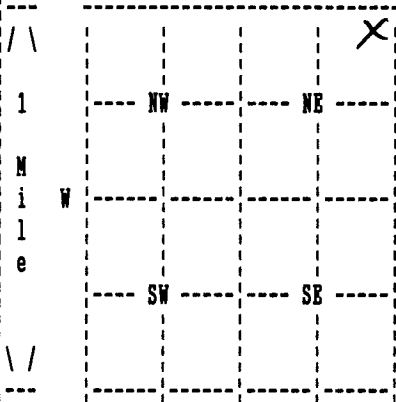

4 DEPTH OF COMPLETED WELL 99 ELEVATION: 0
 Depth(s) Groundwater Encountered 1. 0 ft. 2. 0 ft. 3. 0 ft.

WELL'S STATIC WATER LEVEL 50 ft. below land surface measured on mo/day/yr 03/22/02
 Pump test data: Well water was 0 ft. after 0 hours pumping 0 gpm

Estimated Yield 10 gpm: Well water was 0 ft. after 0 hours pumping 0 gpm

Bore Hole Diameter 8.75 in. to 99 ft., and in. to 0 ft.

WELL WATER TO BE USED AS: LIVESTOCK

Was a chemical/bacteriological sample submitted to department? No ;
 If yes, mo/day/yr sample was submitted Water well disinfected? Yes

5 TYPE OF BLANK CASING USED: PVC CASING JOINTS: GLUED
 Blank casing diameter 5 in. to 89 ft., Dia in. to 0 ft., Dia in. to 0 ft.
 Casing height above land surface 24 in., weight 0 lbs/ft. Wall thickness or gauge No. 26
 TYPE OF SCREEN OR PERFORATION MATERIAL: PVC
 SCREEN OR PERFORATION OPENINGS ARE: SAW CUT

SCREEN PERFORATED INTERVALS: From 89 ft. to 99 ft., From 0 ft. to 0 ft.
 From 0 ft. to 0 ft., From 0 ft. to 0 ft.
 GRAVEL PACK INTERVALS: From 24 ft. to 99 ft., From 0 ft. to 0 ft.
 From 0 ft. to 0 ft., From 0 ft. to 0 ft.

6 GROUT MATERIAL BENTONITE
 Grout Intervals: From 1 ft. to 24 ft., From 0 ft. to 0 ft., From 0 ft. to 0 ft.
 What is the nearest source of possible contamination: ABANDONED WELL
 Direction from well? SOUTH How many feet? 1800

FROM	TO	LITHOLOGIC LOG	FROM	TO	PLUGGING INTERVALS
0	70	TAN CLAY			
70	72	SANDSTONE			
72	77	YELLOW CLAY			
77	82	BROWN SANDSTONE			
82	90	YELLOW CLAY			
90	98	WHITE SANDSTONE			
98	99	GRAY CLAY			

7 CONTRACTOR'S OR LANDOWNER'S CERTIFICATION: This water well was Constructed under my jurisdiction and was completed on (mo/day/year) 03/22/02 and this record is true to the best of my knowledge and belief. Kansas Water Well Contractor's License No. 653 This Water Well Record was completed on (mo/day/yr) 04/25/02 under the business name of DAN HAYSE WATER WELL SVC. by (signature) Dan Hayse