

1 LOCATION OF WATER WELL: Fraction Section Number Township Number Range Number
 County: EDWARDS NE 1/4 NW 1/4 SE 1/4 33 24 19 W

Distance and direction from nearest town or city street address of well if located within city?


NE corner of Hwy. 183 and 10th Street, Kinsley, Kansas

2 WATER WELL OWNER: Bills Muffler Shop

RR#, St. Address, Box #: 224 E. 10th Street
 City, State, ZIP Code : Kinsley, Kansas 67547

Board of Agriculture, Division of Water Resources
 Application Number:

3 MARK WELL'S LOCATION WITH AN "X" IN SECTION BOX:

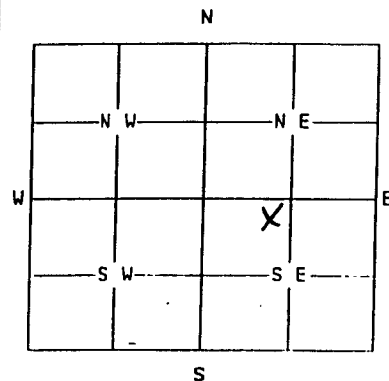

4 DEPTH OF WELL... 15 ft.

WELL'S STATIC WATER LEVEL... 7.96 ft.

WELL WAS USED AS:

- 1 Domestic
- 2 Irrigation
- 3 Feedlot
- 4 Industrial
- 5 Public Water Supply
- 6 Oil Field Water Supply
- 7 Lawn and Garden Only
- 8 Air Conditioning
- 9 Dewatering
- 10 Monitoring Well
- 11 Injection Well
- 12 Other.....

Was a chemical/bacteriological sample submitted to Department? Yes... No.
 If yes, mo/day/yr sample was submitted.....

Water Well Disinfected: Yes..... No.

5 TYPE OF BLANK CASING USED:

- 1 Steel
- 2 PVC
- 3 RMP (SR)
- 4 ABS
- 5 Wrought
- 6 Asbestos-Cement
- 7 Fiberglass
- 8 Concrete Tile
- 9 Other (specify below)

Blank casing diameter... 2 in. Was casing pulled? Yes. No..... If yes, how much... 15'
 Casing height above or below land surface... 0 in.

6 GROUT PLUG MATERIAL: 1 Neat cement 2 Cement grout 3 Bentonite 4 Other.....

Grout Plug Intervals: From... 0 ft. to... 15 ft., From.....ft. to.....ft., From..... to.....ft.

What is the nearest source of possible contamination:

- 1 Septic tank
- 2 Sewer lines
- 3 Watertight sewer lines
- 4 Lateral lines
- 5 Cess Pool
- 6 Seepage pit
- 7 Pit privy
- 8 Sewage lagoon
- 9 Feedyard
- 10 Livestock pens
- 11 Fuel storage
- 12 Fertilizer storage
- 13 Insecticide storage
- 14 Abandoned water well
- 15 Oil well/Gas well
- 16 Other (specify below)

Direction from well? SE How many feet? 115

FROM	TO	PLUGGING MATERIALS
0'	15'	BENTONITE 8"

BMW-7

7 CONTRACTOR'S OR LANDOWNER'S CERTIFICATION: This water well was plugged under my jurisdiction and was completed on (mo/day/year)... 9/12/02 and this record is true to the best of my knowledge and belief. Kansas Water Well Contractor's License No. 527 This Water Well Record was completed on (mo/day/year) 9/20/02 under the business name of GEOCORE, INC by (signature) Bob Hill

INSTRUCTIONS: Use typewriter or ball point pen. Please press firmly and print clearly. Please fill in blanks, underline or circle the correct answers. Send top three copies to Kansas Department of Health and Environment, Bureau of Water, Topeka, Kansas 66620-0001. Telephone: 785/296-3565. Send one to Water Well Owner and retain one for your records.