


1 LOCATION OF WATER WELL: Fraction SW 1/4 NW 1/4 NE 1/4 Section Number 33 Township Number 24 Range Number 19W  
 County: EDWARDS

Distance and direction from nearest town or city street address of well if located within city?  
4th and Colony, Kinsley, Kansas

2 WATER WELL OWNER: Kinsley Cooperative Exchange  
 RR #, St. Address, Box #: 4th and Colony Streets  
 City, State, ZIP Code: Kinsley, Kansas 67547  
 Board of Agriculture, Division of Water Resources  
 Application Number: \_\_\_\_\_

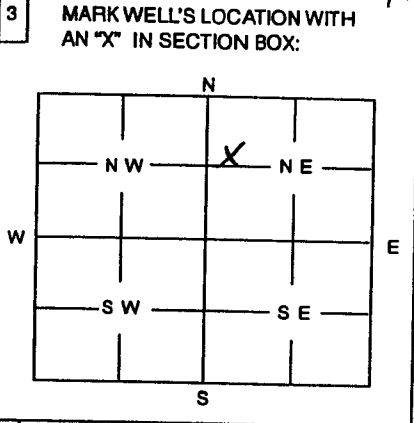

4 DEPTH OF WELL 17.5' ft  
 WELL'S STATIC WATER LEVEL 15' ft  
 WELL WAS USED AS:  
 1 Domestic 2 Irrigation 3 Feedlot 4 Industrial 5 Public Water Supply 6 Oil Field Water Supply 7 Domestic (Lawn & Garden) 8 Air Conditioning 9 Dewatering 10 **Monitoring Well** 11 Injection Well 12 Other \_\_\_\_\_  
 Was a chemical / bacteriological sample submitted to Department? Yes \_\_\_\_\_ No   
 If yes, mo/day/yr sample was submitted \_\_\_\_\_  
 Water Well Disinfected: Yes \_\_\_\_\_ No

5 TYPE OF BLANK CASING USED:  
 1 Steel 2 PVC 3 RMP (SR) 4 ABS 5 Wrought 6 Asbestos-Cement 7 Fiberglass 8 Concrete Tile 9 Other (Specify below) \_\_\_\_\_  
 Blank casing diameter 2 in. Was casing pulled? Yes  No \_\_\_\_\_ If yes, how much 20'  
 Casing height above or below land surface 30 in.

6 GROUT PLUG MATERIAL: 1 Neat cement 2 Cement grout 3 **Bentonite** 4 Other \_\_\_\_\_  
 Grout Plug Intervals: From 0 ft. to 17.5' ft., From \_\_\_\_\_ ft. to \_\_\_\_\_ ft., From \_\_\_\_\_ to \_\_\_\_\_ ft.  
 What is the nearest source of possible contamination:  
 1 Septic tank 2 Sewer lines 3 Watertight sewer lines 4 Lateral lines 5 Cess Pool 6 Seepage pit 7 Pit privy 8 Sewage lagoon 9 Feedyard 10 Livestock pens 11 **Fuel storage** 12 Fertilizer storage 13 Insecticide storage 14 Abandoned water well 15 Oil well/Gas well 16 Other (specify below) \_\_\_\_\_  
 Direction from well? W How many feet? 120'

| FROM | TO    | PLUGGING MATERIALS |
|------|-------|--------------------|
| 0'   | 6.5'  | BENTONITE 8"       |
| 6.5' | 17.5' | BENTONITE 2"       |
|      |       |                    |
|      |       |                    |
|      |       |                    |
|      |       |                    |

MWA 3

7 CONTRACTOR'S OR LANDOWNER'S CERTIFICATION: This water well was plugged under my jurisdiction and was completed on (mo/day/year) 5/5/2003 and this record is true to the best of my knowledge and belief. Kansas Water Well Contractor's License No. 527  
5/13/2003 under the business name of GEOCORE INC. This Water Well Record was completed on (mo/day/year) \_\_\_\_\_  
 by (signature) [Signature]

INSTRUCTIONS: Use typewriter or ball point pen. Please press firmly and print clearly. Please fill in blanks, underline or circle the correct answers. Send top three copies to Kansas Department of Health and Environment, Bureau of Water, Topeka, Kansas 66620-0001. Telephone: 785/296-3565. Send one to Water Well Owner and retain one for your records.