


1 LOCATION OF WATER WELL: Fraction Section Number Township Number Range Number
 County: EDWARDS SW 1/4 NW 1/4 NE 1/4 33 24 19 W

Distance and direction from nearest town or city street address of well if located within city?

4th and Colony Streets, Kinsley Kansas

2 WATER WELL OWNER: Kinsley Cooperative Exchange
 RR #, St. Address, Box #: 4th & Colony Streets
 City, State, ZIP Code : Kinsley Kansas 67547
 Board of Agriculture, Division of Water Resources
 Application Number:

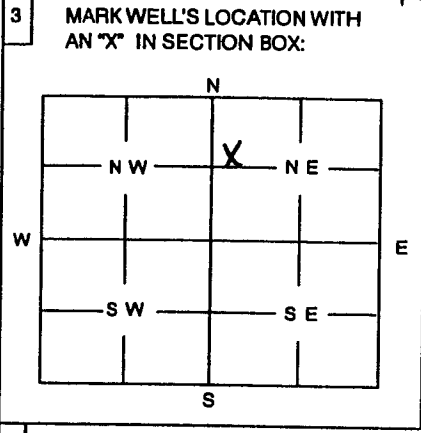

4 DEPTH OF WELL 17.5' ft
 WELL'S STATIC WATER LEVEL 12' ft
 WELL WAS USED AS:
 1 Domestic 5 Public Water Supply 9 Dewatering
 2 Irrigation 6 Oil Field Water Supply 10 Monitoring Well
 3 Feedlot 7 Domestic (Lawn & Garden) 11 Injection Well
 4 Industrial 8 Air Conditioning 12 Other
 Was a chemical / bacteriological sample submitted to Department? Yes No
 If yes, mo/day/yr sample was submitted
 Water Well Disinfected: Yes No

5 TYPE OF CASING USED:
 1 Steel 3 RMP (SR) 5 Wrought 7 Fiberglass 9 Other (Specify below)
 2 PVC 4 ABS 6 Asbestos-Cement 8 Concrete Tile
 Blank casing diameter 2 in. Was casing pulled? Yes No
 Casing height above or below land surface 0 in. If yes, how much

6 GROUT PLUG MATERIAL: 1 Neat cement 2 Cement grout 3 Bentonite 4 Other
 Grout Plug Intervals: From 0 ft. to 17.5 ft., From ft. to ft., From ft. to ft.
 What is the nearest source of possible contamination:
 1 Septic tank 6 Seepage pit 11 Fuel storage 16 Other (specify below)
 2 Sewer lines 7 Pit privy 12 Fertilizer storage
 3 Watertight sewer lines 8 Sewage lagoon 13 Insecticide storage
 4 Lateral lines 9 Feedyard 14 Abandoned water well
 5 Cess Pool 10 Livestock pens 15 Oil well/Gas well
 Direction from well? W How many feet? 20'

FROM	TO	PLUGGING MATERIALS
0'	16'	BENTONITE 8"
16'	17.5'	BENTONITE 2"

MWA 6

7 CONTRACTOR'S OR LANDOWNER'S CERTIFICATION: This water well was plugged under my jurisdiction and was completed on (mo/day/year) 5/18/2003 and this record is true to the best of my knowledge and belief. Kansas Water Well Contractor's License No. 527 This Water Well Record was completed on (mo/day/year) 5/13/2003 under the business name of GEORGE INC. by (signature) [Signature]

INSTRUCTIONS: Use typewriter or ball point pen. Please press firmly and print clearly. Please fill in blanks, underline or circle the correct answers. Send top three copies to Kansas Department of Health and Environment, Bureau of Water, Topeka, Kansas 66620-0001. Telephone: 785/296-3565. Send one to Water Well Owner and retain one for your records.