

WATER WELL RECORD Form WWC-5 KSA 82a-1212

1 LOCATION OF WATER WELL: Fraction **SE 1/4 SE 1/4 NW 1/4** Section Number **33** Township Number **T 24 S** Range Number **R 19 E/W**
County: **Edwards**

Distance and direction from nearest town or city street address of well if located within city?

703 US Highway 56, Kinsley

2 WATER WELL OWNER: **Kansas Dept. of Health & Environment**


RR#, St. Address, Box # : **1000 SW Jackson, Ste. 410**

Board of Agriculture, Division of Water Resources

City, State, ZIP Code : **Topeka, Kansas 66612-1367**

Application Number:

3 LOCATE WELL'S LOCATION WITH AN "X" IN SECTION BOX:

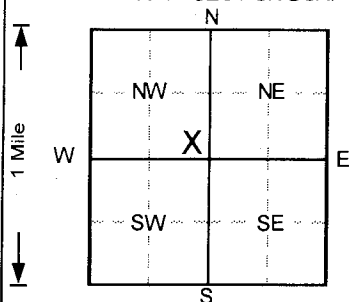

4 DEPTH OF COMPLETED WELL **24** ft. ELEVATION: **2171.59**

Depth(s) Groundwater Encountered 1. ft. 2. ft. 3. ft.

WELL'S STATIC WATER LEVEL ft. below land surface measured on mo/day/yr

Pump test data: Well water was **NA** ft. after hours pumping gpm

Est. Yield **NA** gpm: Well water was ft. after hours pumping gpm

Bore Hole Diameter **8** in. to **24** ft., and in. to ft.

WELL WATER TO BE USED AS: 5 Public water supply 8 Air conditioning (11 Injection well)

1 Domestic 3 Feedlot 6 Oil field water supply 9 Dewatering 12 Other (Specify below)

2 Irrigation 4 Industrial 7 Lawn and garden only 10 Monitoring (wall)

Was a chemical/bacteriological sample submitted to Department? Yes.....No ; If yes, mo/day/yr sample was submitted Water Well Disinfected? Yes No

5 TYPE OF BLANK CASING USED: 1 Steel 2 PVC 3 RMP (SR) 4 ABS 5 Wrought iron 6 Asbestos-Cement 7 Fiberglass 8 Concrete tile 9 Other (specify below) CASING JOINTS: 10 Asbestos-cement 11 Other (specify) 12 None used (open hole) 13 Other (specify)

Blank casing diameter **1** in. to **22** ft., Dia. **1** in. to **24** ft., Dia. in. to ft.

Casing height above land surface **-3.48** in., weight lbs./ft. Wall thickness or gauge No. **Sch. 40**

TYPE OF SCREEN OR PERFORATION MATERIAL: 1 Steel 2 Brass 3 Stainless steel 4 Galvanized steel 5 Fiberglass 6 Concrete tile 7 PVC 8 RMP (SR) 9 ABS 10 Asbestos-cement 11 Other (specify) 12 None used (open hole)

SCREEN OR PERFORATION OPENINGS ARE: 1 Continuous slot 2 Louvered shutter 3 Mill slot 4 Key punched 5 Gauzed wrapped 6 Wire wrapped 7 Torch cut 8 Saw cut 9 Drilled holes 10 Other (specify) 11 None (open hole)

SCREEN-PERFORATED INTERVALS: From **22** ft. to **23** ft., From ft. to ft. From ft. to ft., From ft. to ft.

GRAVEL PACK INTERVALS: From **20** ft. to **24** ft., From ft. to ft. From ft. to ft., From ft. to ft.

6 GROUT MATERIAL: 1 Neat cement 2 Cement grout 3 Bentonite 4 Other

Grout Intervals: From **3** ft. to **20** ft., From ft. to ft., From ft. to ft.

What is the nearest source of possible contamination: 1 Septic tank 2 Sewer lines 3 Watertight sewer lines 4 Lateral lines 5 Cess pool 6 Seepage pit 7 Pit privy 8 Sewage lagoon 9 Feedyard 10 Livestock pens 11 Fuel storage 12 Insecticide storage 14 Abandoned water well 15 Oil well/Gas well 16 Other (specify below)

Direction from well? How many feet?

FROM	TO	LITHOLOGIC LOG	FROM	TO	PLUGGING INTERVALS
0	5	Clay, silty, Lt. Brown			
5	14.5	Sand, vf-m, Lt. Brown			
14.5	15.5	Sand, vf-m, Gray			
15.5	20	Sand, f-c, Lt. Gray-Brown			
20	24	Sand, f-c w/f-m gravel, Brown			

IW6 , Tag # 0047197 , Flushmount

7 CONTRACTOR'S OR LANDOWNER'S CERTIFICATION: This water well was (1) constructed, (2) reconstructed, or (3) plugged under my jurisdiction

and was completed on (mo/day/year) **8/23/2011** and this record is true to the best of my knowledge and belief.

Kansas Water Well Contractor's License No. **527** This Water Well Record was completed on (mo/day/yr) **9/1/11**

under the business name of **GeoCore, Inc.** by (signature) *[Signature]*