


1 LOCATION OF WATER WELL: County: Edwards Fraction SE 1/4 SE 1/4 NW 1/4 Section Number 33 Township Number T 24 S Range Number R 19 EW

Distance and direction from nearest town or city street address of well if located within city? 703 US Highway 56, Kinsley

2 WATER WELL OWNER: Kansas Dept. of Health & Environment RF# , St. Address, Box # : 1000 SW Jackson, Ste. 410 Board of Agriculture, Division of Water Resources City, State, ZIP Code : Topeka, Kansas 66612-1367 Application Number:

3 LOCATE WELL'S LOCATION WITH AN "X" IN SECTION BOX:

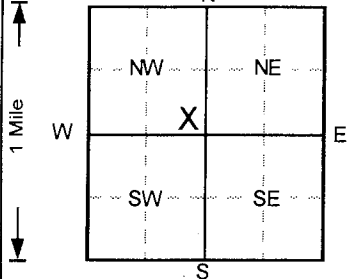

4 DEPTH OF COMPLETED WELL: 24 ft. ELEVATION: 2171.91. Depth(s) Groundwater Encountered 1. ft. 2. ft. 3. ft. WELL'S STATIC WATER LEVEL: ft. below land surface measured on mo/day/yr Pump test data: Well water was NA ft. after hours pumping gpm Est. Yield NA gpm: Well water was ft. after hours pumping gpm Bore Hole Diameter 8. in. to 24. ft., and in. to ft. WELL WATER TO BE USED AS: 5 Public water supply 8 Air conditioning 11 Injection well 1 Domestic 3 Feedlot 6 Oil field water supply 9 Dewatering 12 Other (Specify below) 2 Irrigation 4 Industrial 7 Lawn and garden only 10 Monitoring well Was a chemical/bacteriological sample submitted to Department? Yes No checked; If yes, mo/day/yr sample was submitted Water Well Disinfected? Yes No checked

5 TYPE OF BLANK CASING USED: 1 Steel 3 RMP (SR) 5 Wrought iron 8 Concrete tile CASING JOINTS: Glued Clamped 2 PVC 4 ABS 6 Asbestos-Cement 9 Other (specify below) Welded 7 Fiberglass Threaded checked

Blank casing diameter 1 in. to 22 ft. Dia 1 in. to 24 ft. Dia in. to ft. Casing height above land surface -1.56 in., weight lbs./ft. Wall thickness or gauge No. Sch. 40

TYPE OF SCREEN OR PERFORATION MATERIAL: 1 Steel 3 Stainless steel 5 Fiberglass 7 PVC 10 Asbestos-cement 2 Brass 4 Galvanized steel 6 Concrete tile 8 RMP (SR) 11 Other (specify) 12 None used (open hole)

SCREEN OR PERFORATION OPENINGS ARE: 1 Continuous slot 3 Mill slot 5 Gauzed wrapped 8 Saw cut 11 None (open hole) 2 Louvered shutter 4 Key punched 6 Wire wrapped 9 Drilled holes 7 Torch cut 10 Other (specify)

SCREEN-PERFORATED INTERVALS: From 22 ft. to 23 ft., From ft. to ft., From ft. to ft. GRAVEL PACK INTERVALS: From 20 ft. to 24 ft., From ft. to ft., From ft. to ft.

6 GROUT MATERIAL: 1 Neat cement 2 Cement grout 3 Bentonite 4 Other Grout intervals: From 3 ft. to 20 ft., From ft. to ft., From ft. to ft.

What is the nearest source of possible contamination: 1 Septic tank 4 Lateral lines 7 Pit privy 10 Livestock pens 14 Abandoned water well 2 Sewer lines 5 Cess pool 8 Sewage lagoon 11 Fuel storage 15 Oil well/Gas well 3 Watertight sewer lines 6 Seepage pit 9 Feedyard 12 Fertilizer storage 16 Other (specify below) Direction from well? How many feet?

LITHOLOGIC LOG and PLUGGING INTERVALS table with columns FROM, TO, and descriptions of geological layers and plugging points.

7 CONTRACTOR'S OR LANDOWNER'S CERTIFICATION: This water well was 1 constructed, 2 reconstructed, or 3 plugged under my jurisdiction and was completed on (mo/day/year) 8/24/2011 and this record is true to the best of my knowledge and belief. Kansas Water Well Contractor's License No. 527. This Water Well Record was completed on (mo/day/yr) 9/19/11 under the business name of GeoCore, Inc. by signature Dale Kelle

OFFICE USE ONLY

T

R

EW

SEC.

1/4

1/4

1/4