


WATER WELL RECORD

Form WWC-5

Division of Water Resources App. No.

LOCATION OF WATER WELL: County: Edwards Fraction 1/4 SE 1/4 NW 1/4 SW 1/4 Section Number 33 Township No. T 24 S Range Number R 19 [] E [] W Street/Rural Address of Well Location: 100 ft. SE of intersection of Atwood Ave. & US Hwy 56 WATER WELL OWNER: ADM Grain RR#: Street Address, Box #: 402 US Hwy 56 City, State, ZIP Code : Kinslev, KS. Global Positioning System (GPS) information: Latitude: 37deg 55' 16.85" N Longitude: 99deg 25' 54.40" W Elevation: Datum: [] WGS 84. [] NAD 83. [] NAD 27 Collection Method: [] GPS unit [] Digital Map/Photo [] Topographic Map [] Land Survey Est. Accuracy: [] <3 m. [] 3-5 m. [] 5-15 m. [] >15 m

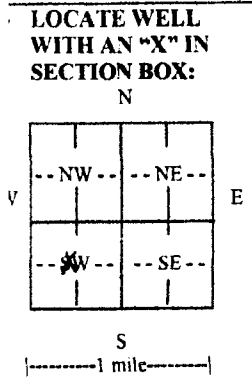

4 DEPTH OF COMPLETED WELL 22 ft. Depth(s) Groundwater Encountered (1) 11.5 ft. (2) (3) WELL'S STATIC WATER LEVEL 11.5 ft. below land surface measured on mo/day/yr. Pump test data: Well water was ... ft. after ... hours pumping ... gpm EST. YIELD ... gpm. Well water was ... ft. after ... hours pumping ... gpm Bore Hole Diameter 6.25 in. to 22 in. and ... in. to ... ft. WELL WATER TO BE USED AS: [] Public water supply [] Geothermal [] Injection well [] Domestic [] Feedlot [] Oil field water supply [] Dewatering [] Other (Specify below) [] Irrigation [] Industrial [] Domestic-lawn & garden [] Monitoring well Was a chemical/bacteriological sample submitted to Department? [] Yes [] No If yes, mo/day/yr sample was submitted. Water well disinfected? [] Yes [] No

TYPE OF CASING USED: [] Steel [] PVC [] Other CASING JOINTS: [] Glued [] Clamped [] Welded [] Threaded Casing diameter 2 in. to 12 ft., Diameter ... in. to ... ft. Casing height above land surface 0 in., Weight ... lbs./ft., Wall thickness or gauge No. sch 40 TYPE OF SCREEN OR PERFORATION MATERIAL: [] Steel [] Stainless Steel [] PVC [] Other (Specify) [] Brass [] Galvanized Steel [] None used (open hole) SCREEN OR PERFORATION OPENINGS ARE: [] Continuous slot [] Mill slot [] Gauze wrapped [] Torch cut [] Drilled holes [] None (open hole) [] Louvered shutter [] Key punched [] Wire wrapped [] Saw cut [] Other (specify) SCREEN-PERFORATED INTERVALS: From 12 ft. to 22 ft., From ... ft. to ... ft. GRAVEL PACK INTERVALS: From 10 ft. to 22 ft., From ... ft. to ... ft.

GROUT MATERIAL: [] Neat cement [] Cement grout [] Bentonite [] Other Grout intervals: From 0 ft. to 10 ft., From ... ft. to ... ft. What is the nearest source of possible contamination: [] Septic tank [] Lateral lines [] Pit privy [] Livestock pens [] Insecticide storage [] Other (specify below) [] Sewer lines [] Cesspool [] Sewage lagoon [] Fuel storage [] Abandoned water well [] Watertight sewer lines [] Seepage pit [] Feedyard [] Fertilizer storage [] Oil well/gas well Direction from well ... Distance from well ...

FROM	TO	LITHOLOGIC LOG	FROM	TO	LITHO. LOG (cont.) or PLUGGING INTERVALS
b	6	Silty clay, brown, soft			
b	10	Silty clay, light brown, stiff			
0	12	Clayey sand, yellow brown, wet			
2	22	Sand, wet			

CONTRACTOR'S OR LANDOWNER'S CERTIFICATION: This water well was [] constructed, [] reconstructed, or [] plugged under my jurisdiction and was completed on (mo/day/year) 12-17-12 and this record is true to the best of my knowledge and belief. Kansas Water Well Contractor's License No. 604 This Water Well Record was completed on (mo/day/year) 2/11/13 under the business name of Environmental Priority Service, inc. by (signature) ... INSTRUCTIONS: Use typewriter or ball point pen. PLEASE PRESS FIRMLY and PRINT clearly. Please fill in blanks and check the correct answers. Send three copies white, blue, pink) to Kansas Department of Health and Environment, Bureau of Water, Geology Section, 1000 SW Jackson St., Suite 420, Topeka, Kansas 66612-1367. Telephone 785-296-5524. Send one copy to WATER WELL OWNER and retain one for your records. Include fee of \$5.00 for each constructed well. Visit us at http://www.kdheks.gov/waterwell/index.html