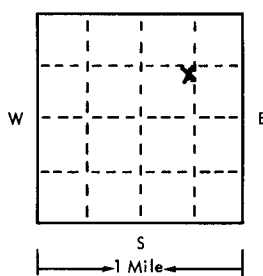
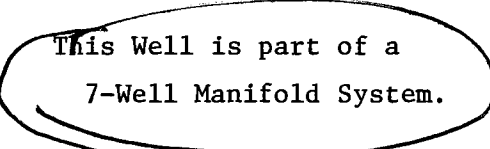


USE TYPEWRITER OR BALL
POINT PEN-PRESS FIRMLY,
PRINT CLEARLY.

WATER WELL RECORD
KSA 82a-1201-1215

T R EW sec 1/4 1/4 1/4 No.

Kansas State Dept. Of Health
(Water Well Contractors)
Forbes-Bldg. 740
Topeka, Kansas 66620

1 Location of well:	County Edwards	Township name Kinsley	Fraction SW of NE 1/4	Section number 22	Town number T24S	Range number R19W
Distance and direction from nearest town or city: 3 mi. Northeast of Kinsley, Kansas Street address of well location if in city:				3 Owner of well: Tom Fox (#5) Address: Kinsley, Kansas		
Locate with "X" in section below: N  W E S 1 Mile		Sketch map: 		4 Well depth: 28 ft. Date of completion 6-9-75 Well diameter 24 in.		
2 Type and color of material		From	To	5 <input type="checkbox"/> Cable tool <input type="checkbox"/> Rotary <input type="checkbox"/> Driven <input type="checkbox"/> Dug <input type="checkbox"/> Hollow rod <input type="checkbox"/> Jetted <input type="checkbox"/> Bored <input checked="" type="checkbox"/> Reverse rotary		
Top soil & clay		0	7	6 Use: <input type="checkbox"/> Domestic <input type="checkbox"/> Public supply <input type="checkbox"/> Industry <input checked="" type="checkbox"/> Irrigation <input type="checkbox"/> Air conditioning <input type="checkbox"/> Commercial <input type="checkbox"/> Test well <input type="checkbox"/>		
Fine sand		7	9	7 Casing: Material Steel Height: above /below Threaded <input type="checkbox"/> Welded <input checked="" type="checkbox"/> Surface 12 in. 17 1/2 Diam. Weight XXXX lbs./ft. 12 in. to 8 ft. depth Drive shoe? <input type="checkbox"/> Yes <input checked="" type="checkbox"/> No 12 in. to 28 ft. depth		
Sand & gravel		9	21	8 Screen: Manufacturer Doerr Type Double-slot Dia. 12" Slot gauze 1/8 Length 12' Set between 8 ft. and 20 ft. Fittings: 3/8 200 Gravel pack <input checked="" type="checkbox"/> Yes <input type="checkbox"/> No Size range of material		
Brown clay & gravel		21	25	9 Static water level: 4 ft. below land surface Date 6-9-75		
Brown clay		25	28	10 Pumping level below land surfaces: N/C ____ ft. after ____ hrs. pumping ____ g.p.m. ____ ft. after ____ hrs. pumping ____ g.p.m. Estimated maximum yield ____ g.p.m.		
				11 Water sample submitted: <input type="checkbox"/> Yes <input checked="" type="checkbox"/> No Date		
				12 Well head completion: <input type="checkbox"/> Pitless adapter 12 Inches above grade		
				13 Well grouted? <input checked="" type="checkbox"/> Yes <input type="checkbox"/> No <input checked="" type="checkbox"/> Neat cement <input type="checkbox"/> Bentonite <input type="checkbox"/> Depth: From 0 ft. to 10 ft.		
				14 Nearest source of possible contamination: ft. ____ Direction ____ Type ____ Well disinfected upon completion? <input type="checkbox"/> Yes <input checked="" type="checkbox"/> No		
				15 Pump: <input checked="" type="checkbox"/> Not installed Manufacturer's name ____ Model number ____ HP ____ Volts ____ Length of drop pipe ____ ft. capacity ____ g.m.p. Type: <input type="checkbox"/> Submersible <input type="checkbox"/> Turbine <input type="checkbox"/> Jet <input type="checkbox"/> Reciprocating <input type="checkbox"/> Centrifugal <input type="checkbox"/> Other		
16 Remarks: elevation		17 Water well contractor's certification: This well was drilled under my jurisdiction and this report is true to the best of my knowledge and belief. Clarke Well & Eq., Inc. 185 Business name License No. Address Great Bend, KS Signed D. W. Clark Date 6-9-75 Authorized representative				
Topography: <input type="checkbox"/> Hill <input type="checkbox"/> Slope <input type="checkbox"/> Upland <input type="checkbox"/> Valley						

Forward the white, blue and pink copies to the Kansas State Dept. Of Health.

Form WWC-5