

WATER WELL PLUGGING RECORD Form WWC-5P

KSA 82a-1212 ID NO.

1 LOCATION OF WATER WELL: County: <u>Edwards</u>	Fraction <u>SW 1/4 SE 1/4 SE 1/4 NW 1/4</u>	Section Number <u>33</u>	Township Number <u>24 S</u>	Range Number <u>19</u> <input type="checkbox"/> E <input checked="" type="checkbox"/> W
------------------------------------------------------------	------------------------------------------------	-----------------------------	--------------------------------	--------------------------------------------------------------------------------------------

Street/Rural Address of Well Location; if unknown, distance and direction from nearest town or intersection. If at owner's address, check here <input type="checkbox"/> <u>703 US Hwy 56, Kinsley</u>	Global Positioning Systems (GPS) Information: Latitude: <u>37.921192</u> (in decimal degrees) Longitude: <u>-99.415931</u> (in decimal degrees) Elevation: <u>~2291</u> Datum: <input checked="" type="checkbox"/> WGS84 <input type="checkbox"/> NAD83 <input type="checkbox"/> NAD27 Collection Method: <input type="checkbox"/> GPS unit Make/Model: _____ <input checked="" type="checkbox"/> Digital Map/Photo <input type="checkbox"/> Topographic Map <input type="checkbox"/> Land Survey Est. Accuracy: <input type="checkbox"/> <3 m <input checked="" type="checkbox"/> 3-5 m <input type="checkbox"/> 5-15 <input type="checkbox"/> >15
---	---

2 WATER WELL OWNER: <u>Kansas Dept of Health & Environ.</u> RR#, St. Address, Box # <u>1000 SW Jackson, Suite 410</u> City, State ZIP Code <u>Topeka, KS 66612-1367</u>	
---	--

3 MARK WELL'S LOCATION WITH AN "X" IN SECTION BOX: <div style="text-align: center;"> </div>	4 DEPTH OF WELL: <u>24.08</u> ft. WELL'S STATIC WATER LEVEL: _____ ft. WELL WAS USED AS: <input type="checkbox"/> Domestic <input type="checkbox"/> Public Water Supply <input type="checkbox"/> Dewatering <input type="checkbox"/> Irrigation <input type="checkbox"/> Old Field Water Supply <input type="checkbox"/> Monitoring <input type="checkbox"/> Feedlot <input type="checkbox"/> Domestic (Lawn/Garden) <input checked="" type="checkbox"/> Injection Well <input type="checkbox"/> Industrial <input type="checkbox"/> Air Conditioning <input type="checkbox"/> Other _____ Was a chemical/bacteriological sample submitted to Department? <input type="checkbox"/> Yes <input checked="" type="checkbox"/> No
---	---

5 TYPE OF BLANK CASING USED:

<input type="checkbox"/> Steel	<input type="checkbox"/> RMP (SR)	<input type="checkbox"/> Wrought	<input type="checkbox"/> Fiberglass	<input type="checkbox"/> Other:
<input checked="" type="checkbox"/> PVC	<input type="checkbox"/> ABS	<input type="checkbox"/> Asbestos/Cement	<input type="checkbox"/> Concrete Tile	_____

Blank casing diameter: 1 in. Was casing pulled? Yes No If Yes, how much 3'

Casing height above or below land surface: _____ in.

6 GROUT PLUG MATERIAL: Neat cement Cement grout Bentonite Other: _____

Grout Plug Intervals: From 3 ft. To 24.08 ft. From _____ ft. To _____ ft. From _____ ft. To _____ ft.


What is the nearest source of possible contamination:

<input type="checkbox"/> Septic tank	<input type="checkbox"/> Seepage pit	<input type="checkbox"/> Fuel storage	<input checked="" type="checkbox"/> Other (specify below):
<input type="checkbox"/> Sewer lines	<input type="checkbox"/> Pit privy	<input type="checkbox"/> Fertilizer storage	<u>Contaminated Site</u>
<input type="checkbox"/> Watertight sewer lines	<input type="checkbox"/> Sewage lagoon	<input type="checkbox"/> Insecticide storage	Direction from well: _____
<input type="checkbox"/> Lateral lines	<input type="checkbox"/> Feedyard	<input type="checkbox"/> Abandoned water well	How many feet: _____
<input type="checkbox"/> Cess pool	<input type="checkbox"/> Livestock pens	<input type="checkbox"/> Oil well/Gas well	

FROM	TO	PLUGGING MATERIAL	FROM	TO	PLUGGING MATERIAL
0	3	Native soil			
3	24.08	Bentonite (1")			
					IW-7

7 CONTRACTOR'S OR LANDOWNER'S CERTIFICATION: This water well was plugged under my jurisdiction and was completed on (mo/day/year) 5/10/2017 and this record is true to the best of my knowledge and belief. Kansas Water Well Contractor's License No. 527. This Water Well Record was completed on (mo/day/year) 5/19/2017 under the business name of GeoCore Inc. by (signature) *Dale Kell*

INSTRUCTIONS: Use typewriter or ballpoint pen. Please press firmly and print clearly. Please fill in blanks, underline or circle the correct answers. Send one copy to Kansas Department of Health and Environment, Bureau of Water, Geology Section, 1000 SW Jackson St., Ste. 420, Topeka, Kansas 66612-1367. Telephone 785/296-5524. Send one to Water Well Owner and retain one for your records. Visit us at <http://www.kdheks.gov/waterwell/index.html>.

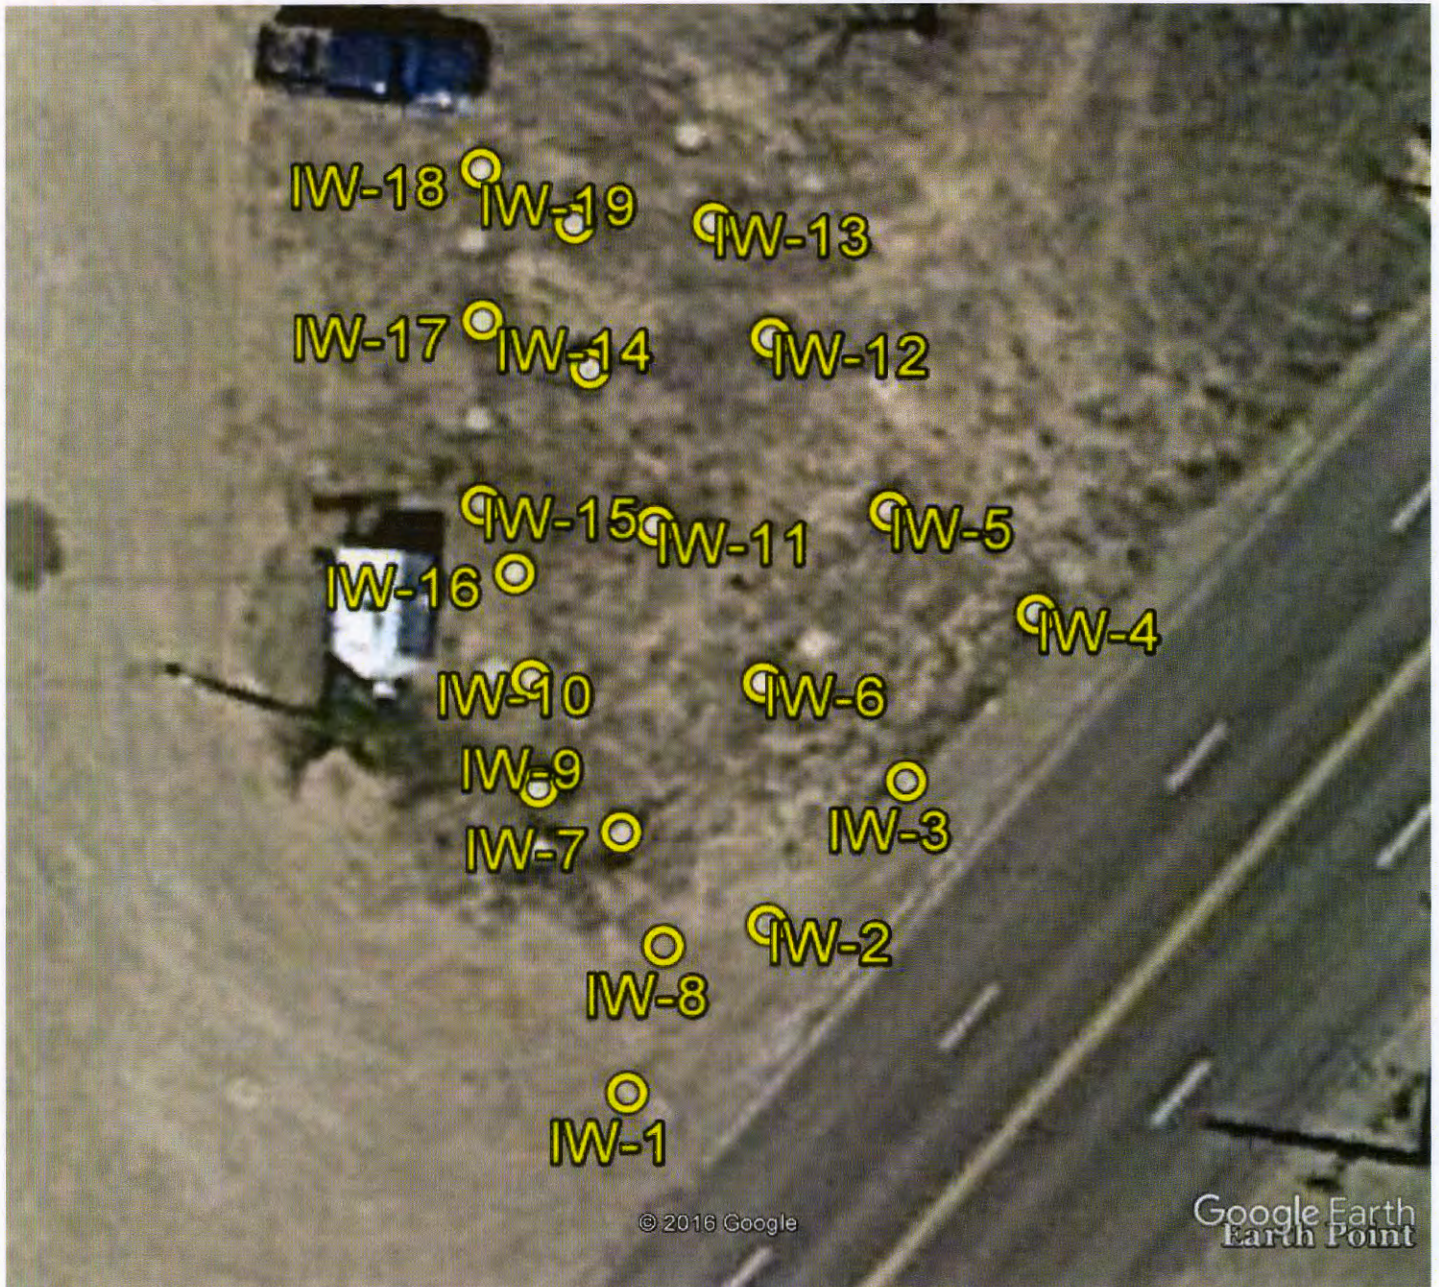

Google Earth



Former Moletor Estates
 703 US 56, Kinsley, Kansas
 KDHE Project Code: U1-024-00112

GPS Coordinates:

IW-1: 37.921124, -99.415929
 IW-2: 37.921167, -99.415883
 IW-3: 37.921205, -99.415837
 IW-4: 37.921248, -99.415794
 IW-5: 37.921275, -99.415843
 IW-6: 37.921230, -99.415884
 IW-7: 37.921192, -99.415931

IW-8: 37.921162, -99.415917
 IW-9: 37.921203, -99.415958
 IW-10: 37.921231, -99.415960
 IW-11: 37.921271, -99.415920
 IW-12: 37.921320, -99.415882
 IW-13: 37.921349, -99.415901
 IW-14: 37.921312, -99.415941

IW-15: 37.921276, -99.415977
 IW-16: 37.921259, -99.415966
 IW-17: 37.921324, -99.415977
 IW-18: 37.921363, -99.415977
 IW-19: 37.921349, -99.415946

RECEIVED

MAY 31 2017

BUREAU OF WATER