USE TYPEWRITER OR BALL POINT PEN-PRESS FIRMLY, PRINT CLEARLY.

WATER WELL RECORD
KSA 82a-1201-1215

Kansas Department of Health and Environment-Division of Environment
(Water well Contractors)
Topeka, Kansas 66620

1. Location of well:	County	Fraction	Section number	Township number	Range number
	Harvey	1/4 NW 1/4 NE 1/4	2	T 24 S	R 2W E/W

2. Distance and direction from nearest town or city:
Street address of well location if in city: 729 Chestnut Halstead, KS

3. Owner of well: Marion Stutzman
R.R. or street: 729 Chestnut
City, state, zip code: Halstead, KS

4. Locate with "X" in section below:

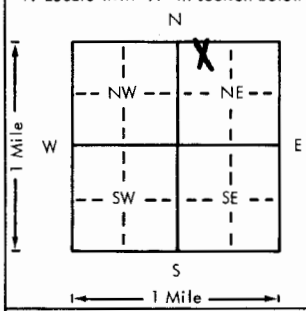

Sketch map:

6. Bore hole dia. 11 in. Completion date
Well depth 47 ft. 10-27-78

7. __ Cable tool X Rotary __ Driven __ Dug
__ Hollow rod __ Jetted __ Bored __ Reverse rotary

8. Use: __ Domestic __ Public supply __ Industry
__ Irrigation __ Air conditioning __ Stock
X Lawn __ Oil field water __ Other

9. Casing: Material Styrene Height: Above or below
Threaded ___ Welded gl Surface 12 in.
RMP X PVC ___ Weight ___ lbs./ft.
Dia. 5 in. to 47 ft. depth Wall Thickness: inches or
Dia. ___ in. to ___ ft. depth gage No. .200

5. Type and color of material	From	To
Topsoil	0	3
Clay	3	25
Fine Sand to Medium Sand	25	47

10. Screen: Manufacturer's name Sunflower plastic
Type styrene Dia. 5"
Slot/gauze .06 Length 15'
Set between 32 ft. and 47 ft.
___ ft. and ___ ft.
Gravel pack? yes Size range of material 1/4-1/8"

11. Static water level: mo./day/yr.
23 ft. below land surface Date 10-27-78

12. Pumping level below land surfaces:
___ ft. after ___ hrs. pumping ___ g.p.m.
___ ft. after ___ hrs. pumping ___ g.p.m.
Estimated maximum yield ___ g.p.m.

13. Water sample submitted: mo./day/yr.
___ Yes ___ No Date ___

14. Well head completion: Well seal
___ Pitless adapter 12 Inches above grade

15. Well grouted? yes 1-2fine sand mix
With: ___ Neat cement ___ Bentonite X Concrete
Depth: From 40"/4. to 14 ft.

16. Nearest source of possible contamination:
ft. 60 Direction West Type City Sewer
Well disinfected upon completion? X Yes ___ No

17. Pump: ___ Not installed
Manufacturer's name Jacuzzi
Model number 7S4C HP 3/4 Volts 230
Length of drop pipe 40 ft. capacity 18 g.p.m.
Type:
X Submersible ___ Turbine
___ Jet ___ Reciprocating
___ Centrifugal ___ Other

(Use a second sheet if needed)

18. Elevation: Flat Ground
Topography:
___ Hill
___ Slope
___ Upland
___ Valley

19. Remarks:

20. Water well contractor's certification:
This well was drilled under my jurisdiction and this report is true to the best of my knowledge and belief.
Harp Well & Pump 236
Business name License No.
Address Wichita, Kansas 67209
Signed M. Arnold Date 6-20-79
Authorized representative

T 24 - R 2W E - Sec 2 - 1/4 1/4 1/4 NW NE

Forward the white, blue and pink copies to the Department of Health and Environment

Form WWC-5