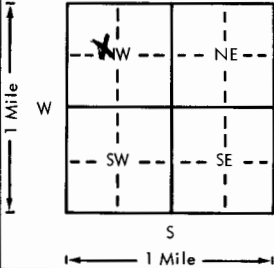
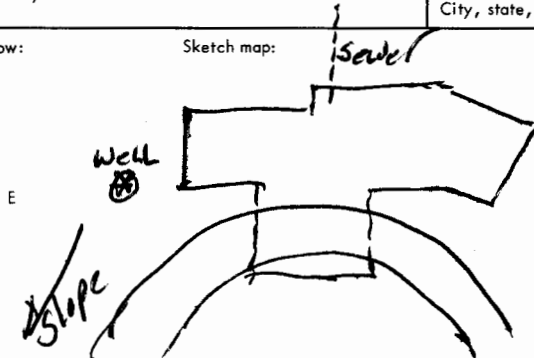


USE TYPEWRITER OR BALL
POINT PEN-PRESS FIRMLY,
PRINT CLEARLY.

WATER WELL RECORD
KSA 82a-1201-1215

Kansas Department of Health and
Environment-Division of Environment
(Water well Contractors)
Topeka, Kansas 66620

1. Location of well:		County HARVEY	Fraction SE 1/4 NW 1/4 NW 1/4	Section number 2	Township number T 24 S R 2 E W	Range number
2. Distance and direction from nearest town or city: SAME		3. Owner of well: Dr Sham Sharfuddin Shah		R.R. or street: HALSTEAD, KNS		
Street address of well location if in city:		City, state, zip code:				
4. Locate with "X" in section below:		Sketch map:		6. Bore hole dia. 10 in. Completion date 8-9-77 Well depth 51 ft.		
				7. <input type="checkbox"/> Cable tool <input checked="" type="checkbox"/> Rotary <input type="checkbox"/> Driven <input type="checkbox"/> Dug <input type="checkbox"/> Hollow rod <input type="checkbox"/> Jetted <input type="checkbox"/> Bored <input type="checkbox"/> Reverse rotary		
5. Type and color of material		From		To		8. Use: <input type="checkbox"/> Domestic <input type="checkbox"/> Public supply <input type="checkbox"/> Industry <input checked="" type="checkbox"/> Irrigation <input type="checkbox"/> Air conditioning <input type="checkbox"/> Stock <input checked="" type="checkbox"/> Lawn <input type="checkbox"/> Oil field water <input type="checkbox"/> Other
Leam		0		5		9. Casing: Material plastic Height: above or below Threaded <input type="checkbox"/> Welded <input checked="" type="checkbox"/> Surface 12" in. RMP <input type="checkbox"/> PVC <input checked="" type="checkbox"/> Weight 228 lbs./ft. Dia. 5 in. to 51 ft. depth Wall Thickness: inches or Dia. <input type="checkbox"/> in. to <input type="checkbox"/> ft. depth gage No. 228
Lgt br clay-SANDY		5		10		10. Screen: Manufacturer's name Kem-Tech - dual slot Type PVC Dia. 5" Slot/gauze 1046 Length 20' Set between 30 ft. and 50 ft. ft. and <input type="checkbox"/> ft.
fine SAND		10		15		Gravel pack? <input checked="" type="checkbox"/> Size range of material 4/2-1/4
" to med SAND		15		20		11. Static water level: <input type="checkbox"/> mo./day/yr. 16 ft. below land surface Date 6-16-77
SAND MED		20		35		12. Pumping level below land surfaces: 18' ft. after 1 hrs. pumping 20 g.p.m. <input type="checkbox"/> ft. after <input type="checkbox"/> hrs. pumping <input type="checkbox"/> g.p.m. Estimated maximum yield 120 g.p.m.
SAND coarse		35		40		13. Water sample submitted: <input type="checkbox"/> Yes <input checked="" type="checkbox"/> No Date <input type="checkbox"/>
SAND " to gravel		40		45		14. Well head completion: <input type="checkbox"/> Pitless adapter 12 inches above grade
green grey clay (soft shale)		45		47		15. Well grouted? <input checked="" type="checkbox"/> With: <input checked="" type="checkbox"/> Neat cement <input type="checkbox"/> Bentonite <input type="checkbox"/> Concrete Depth: From 10 ft. to 0 ft.
fine SAND		47		50		16. Nearest source of possible contamination: ft. 36' Direction North Type sewer Well disinfected upon completion? <input type="checkbox"/> Yes <input checked="" type="checkbox"/> No
green grey soft shale		50		51		17. Pump: <input type="checkbox"/> Not installed Manufacturer's name Oy-200-Dampster Model number <input type="checkbox"/> HP 2 Volts 230 Length of drop pipe 40' ft. capacity 60 g.p.m. Type: <input checked="" type="checkbox"/> Submersible <input type="checkbox"/> Turbine <input type="checkbox"/> Jet <input type="checkbox"/> Reciprocating <input type="checkbox"/> Centrifugal <input type="checkbox"/> Other
(Use a second sheet if needed)						
18. Elevation:		19. Remarks:		20. Water well contractor's certification: This well was drilled under my jurisdiction and this report is true to the best of my knowledge and belief. PAINE'S INC #175 Business name License No. Address HESTON, KNS Signed Paul Bumbert Date 6-23-77 Authorized representative		
Topography: <input type="checkbox"/> Hill <input type="checkbox"/> Slope <input type="checkbox"/> Upland <input type="checkbox"/> Valley						