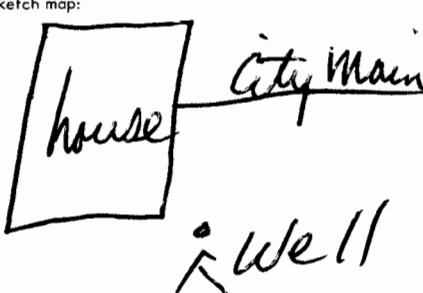


USE TYPEWRITER OR BALL
POINT PEN-PRESS FIRMLY,
PRINT CLEARLY.

WATER WELL RECORD
KSA 82a-1201-1215

Kansas Department of Health and
Environment-Division of Environment
(Water well Contractors)
Topeka, Kansas 66620

1. Location of well:	County <u>Harvey.</u>	Fraction <u>SE 1/4 NW 1/4 NE 1/4</u>	Section number <u>2</u>	Township number <u>T 24</u>	Range number <u>S R 2</u>
2. Distance and direction from nearest town or city: Street address of well location if in city: <u>126 Chestnut</u>			3. Owner of well: <u>Ben Umruh</u> R.R. or street: <u>926 Chestnut</u> City, state, zip code: <u>Halstead KS</u>		
4. Locate with "X" in section below: N W E S 1 Mile		Sketch map: 		6. Bore hole dia. <u>4</u> in. Completion date <u>10/26/78</u> Well depth <u>50</u> ft.	
				7. <u>X</u> Cable tool <u>X</u> Rotary <u> </u> Driven <u> </u> Dug <u> </u> <u> </u> Hollow rod <u> </u> Jetted <u> </u> Bored <u> </u> Reverse rotary	
				8. Use: <u> </u> Domestic <u> </u> Public supply <u> </u> Industry <u> </u> Irrigation <u> </u> Air conditioning <u> </u> Stock <u>X</u> Lawn <u> </u> Oil field water <u> </u> Other	
				9. Casing: Material <u>Steel</u> Height: Above or below Threated <u> </u> Welded <u>X</u> Surface <u>12</u> in. RMP <u>X</u> PVC <u> </u> Weight <u>1.30</u> lbs./ft. Dia. <u>5</u> in. to <u>50</u> ft. depth Wall Thickness: inches or Dia. <u> </u> in. to <u> </u> ft. depth gage No. <u>1200</u>	
5. Type and color of material		From	To	10. Screen: Manufacturer's name <u>Sunflower</u> Type <u>200</u> Dia. <u>5 in</u> Slot/gauze <u>1/16</u> Length <u>6 ft</u> Set between <u>42</u> ft. and <u>48</u> ft. <u> </u> ft. and <u> </u> ft. Gravel pack? <u>Yes</u> Size range of material <u>3/8</u>	
<u>Top soil.</u>		<u>0</u>	<u>3</u>	11. Static water level: <u>25</u> ft. below land surface Date <u>10/26/78</u>	
<u>gray clay.</u>		<u>3</u>	<u>34</u>	12. Pumping level below land surfaces: <u>28</u> ft. after <u>1/2</u> hrs. pumping <u>15</u> g.p.m. <u> </u> ft. after <u> </u> hrs. pumping <u> </u> g.p.m. Estimated maximum yield <u>20-25</u> g.p.m.	
<u>fine sand.</u>		<u>34</u>	<u>38</u>	13. Water sample submitted: <u> </u> mo./day/yr. <u> </u> Yes <u>X</u> No Date <u> </u>	
<u>gray clay</u>		<u>38</u>	<u>39</u>	14. Well head completion: <u> </u> Pitless adapter <u>12</u> inches above grade	
<u>med. gravel</u>		<u>39</u>	<u>44</u>	15. Well grouted? <u>Yes</u> With: <u> </u> Neat cement <u> </u> Bentonite <u>X</u> Concrete Depth: From <u>0</u> ft. to <u>10</u> ft.	
<u>gray clay.</u>		<u>44</u>	<u>50</u>	16. Nearest source of possible contamination ft. <u>50</u> Direction <u>No.</u> Type <u>City main</u> Well disinfected upon completion? <u>X</u> Yes <u> </u> No	
				17. Pump: Manufacturer's name <u>Pumpco.</u> Model number <u>19508</u> HP <u>1/2</u> Vol <u>220</u> Length of drop pipe <u>40</u> ft. capacity <u>18</u> g.p.m. Type: <u>X</u> Submersible <u> </u> Turbine <u> </u> Jet <u> </u> Reciprocating <u> </u> Centrifugal <u> </u> Other	
18. Elevation:		19. Remarks: <u>Customer to furnish 4x4x4"</u> <u>slab around casing per</u> <u>State Regulations</u> <u>Signed X Ben Umruh.</u>		20. Water well contractor's certification: This well was drilled under my jurisdiction and this report is true to the best of my knowledge and belief. Business name <u>Wm. J. Umruh</u> License No. <u>318</u> Address <u>Halstead KS</u> Signed <u>Wm. J. Umruh</u> Date <u>10/26/78</u> Authorized representative	