


1 LOCATION OF WATER WELL:	Fraction	Section Number	Township Number	Range Number
County: <u>Harvey</u>	<u>NW 1/4 NW 1/4 NW 1/4</u>	<u>2</u>	T <u>24</u> S	R <u>2</u> E <u>(N)</u>

Distance and direction from nearest town or city street address of well if located within city?

907 W 6th  
 2 WATER WELL OWNER: Halstead Housing  
 RR#, St. Address, Box #: 907 W 6th  
 City, State, ZIP Code: Halstead, KS 67056

Board of Agriculture, Division of Water Resources  
 Application Number:

3 LOCATE WELL'S LOCATION WITH AN "X" IN SECTION BOX:	4 DEPTH OF COMPLETED WELL: <u>48</u> ft. ELEVATION:
--	---

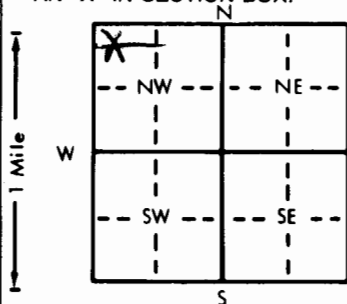

Depth(s) Groundwater Encountered 1. 25 ft. 2. ft. 3. ft.  
 WELL'S STATIC WATER LEVEL 25 ft. below land surface measured on mo/day/yr 8-6-84  
 Pump test data: Well water was ft. after hours pumping gpm  
 Est. Yield 30+ gpm: Well water was ft. after hours pumping gpm  
 Bore Hole Diameter 11 in. to 48 ft., and in. to ft.  
 WELL WATER TO BE USED AS:  
 1 Domestic 3 Feedlot 6 Oil field water supply 9 Dewatering 12 Other (Specify below)  
 2 Irrigation 4 Industrial 7 Lawn and garden only 10 Observation well  
 Was a chemical/bacteriological sample submitted to Department? Yes No X; If yes, mo/day/yr sample was submitted Water Well Disinfected? Yes No

5 TYPE OF BLANK CASING USED:	5 Wrought iron	8 Concrete tile	CASING JOINTS: Glued <u>X</u> Clamped
1 Steel	3 RMP (SR)	6 Asbestos-Cement	9 Other (specify below)
<u>2 PVC</u>	4 ABS	7 Fiberglass	Welded
Blank casing diameter <u>6"</u> in. to <u>28</u> ft., Dia			Threaded

Casing height above land surface 18 in., weight 3.36 lbs./ft. Wall thickness or gauge No. 225

TYPE OF SCREEN OR PERFORATION MATERIAL:	5 Fiberglass	8 RMP (SR)	10 Asbestos-cement
1 Steel	3 Stainless steel	6 Concrete tile	9 ABS
2 Brass	4 Galvanized steel		11 Other (specify)
			12 None used (open hole)

SCREEN OR PERFORATION OPENINGS ARE:	5 Gauzed wrapped <u>.025</u>	8 Saw cut <u>Factory</u>	11 None (open hole)
1 Continuous slot	3 Mill slot	6 Wire wrapped	9 Drilled holes
2 Louvered shutter	4 Key punched	7 Torch cut	10 Other (specify)

SCREEN-PERFORATED INTERVALS: From 28 ft. to 48 ft., From ft. to ft.  
 GRAVEL PACK INTERVALS: From 10 ft. to 48 ft., From ft. to ft.  
 From ft. to ft., From ft. to ft.

6 GROUT MATERIAL:	1 Neat cement	2 Cement grout	<u>3 Bentonite</u>	4 Other
Grout Intervals: From <u>0</u> ft. to <u>10</u> ft., From ft. to ft., From ft. to ft.				

What is the nearest source of possible contamination:  
 1 Septic tank 4 Lateral lines 7 Pit privy 10 Livestock pens 14 Abandoned water well  
2 Sewer lines 5 Cess pool 8 Sewage lagoon 11 Fuel storage 15 Oil well/Gas well  
 3 Watertight sewer lines 6 Seepage pit 9 Feedyard 12 Fertilizer storage 16 Other (specify below)  
 13 Insecticide storage

Direction from well? North West How many feet? 58

FROM	TO	LITHOLOGIC LOG	FROM	TO	LITHOLOGIC LOG
<u>0</u>	<u>5</u>	<u>Fill &amp; beam</u>			
<u>5</u>	<u>15</u>	<u>brown clay</u>			
<u>15</u>	<u>25</u>	<u>dark clay</u>			
<u>25</u>	<u>38</u>	<u>Sand fine to medium</u>			
<u>38</u>	<u>45</u>	<u>Sand med coarse</u>			
<u>45</u>	<u>48</u>	<u>grey clay</u>			

7 CONTRACTOR'S OR LANDOWNER'S CERTIFICATION: This water well was <u>(1)</u> constructed, <u>(2)</u> reconstructed, or <u>(3)</u> plugged under my jurisdiction and was completed on (mo/day/year) <u>8-6-84</u> and this record is true to the best of my knowledge and belief. Kansas Water Well Contractor's License No. <u>457</u> This Water Well Record was completed on (mo/day/yr) <u>8-20-85</u> under the business name of <u>United Water Well &amp; Pump</u> by (signature) <u>Paul Buntin</u>
---

INSTRUCTIONS: Use typewriter or ball point pen, PLEASE PRESS FIRMLY and PRINT clearly. Please fill in blanks, underline or circle the correct answers. Send top three copies to Kansas Department of Health and Environment, Division of Environment, Environmental Geology Section, Topeka, KS 66620. Send one to WATER WELL OWNER and retain one for your records.