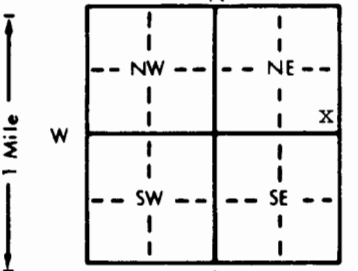


1 LOCATION OF WATER WELL:		Fraction	Section Number		Township Number	Range Number
County: Harvey		SE 1/4 SE 1/4 NE 1/4	6		T 24 S	R 2 E/W
Distance and direction from nearest town or city street address of well if located within city? Approximately 3 1/2 miles west of Halstead						
2 WATER WELL OWNER:		Wichita, City of		Board of Agriculture, Division of Water Resources		
RR#, St. Address, Box # :		12th Floor City Building		Application Number: 388 & VR HV-0006		
City, State, ZIP Code :		455 N. Main Wichita, KS 67202				
3 LOCATE WELL'S LOCATION WITH AN "X" IN SECTION BOX:		4 DEPTH OF COMPLETED WELL: 257 ft. ELEVATION: unknown				
		Depth(s) Groundwater Encountered 1. .... ft. 2. .... ft. 3. .... ft.				
		WELL'S STATIC WATER LEVEL 57.15 ft. below land surface measured on mo/day/yr 7-9-91				
		Pump test data: Well water was 89.04 ft. after 2 hours pumping 1400 gpm				
		Est. Yield gpm: Well water was 89.09 ft. after 5 hours pumping 1400 gpm				
		Bore Hole Diameter 42 in. to 256 ft., and .... in. to .... ft.				
		WELL WATER TO BE USED AS: 5 Public water supply 8 Air conditioning 11 Injection well				
		1 Domestic 3 Feedlot 6 Oil field water supply 9 Dewatering 12 Other (Specify below)				
		2 Irrigation 4 Industrial 7 Lawn and garden only 10 Monitoring well				
		Was a chemical/bacteriological sample submitted to Department? Yes.....No.....X.....; If yes, mo/day/yr sample was submitted				
		This is an offset well drilled for Water Well Disinfected? Yes X No				
5 TYPE OF BLANK CASING USED:		5 Wrought iron replacement 8 Concrete tile CASING JOINTS: Glued ..... Clamped .....				
1 Steel 3 RMP (SR)		6 Asbestos-Cement 9 Other (specify below) Welded X				
2 PVC 4 ABS		7 Fiberglass stainless steel Threaded				
Blank casing diameter 18" to 117' in. to 18" to 192' ft. Dia 18" to 122' in. to 18" to 136' ft. Dia 18" to 156' in. to 18" to 197' in. to 18" to 256' ft.						
Casing height above land surface 12 in., weight 70.59 (steel) lbs./ft. Wall thickness or gauge No. 375 & 180 steel stainless steel						
TYPE OF SCREEN OR PERFORATION MATERIAL:		7 PVC 10 Asbestos-cement				
1 Steel 3 Stainless steel 5 Fiberglass 8 RMP (SR) 11 Other (specify) .....						
2 Brass 4 Galvanized steel 6 Concrete tile 9 ABS 12 None used (open hole)						
SCREEN OR PERFORATION OPENINGS ARE:		5 Gauzed wrapped 8 Saw cut 11 None (open hole)				
1 Continuous slot 3 Mill slot 6 Wire wrapped 9 Drilled holes						
2 Louvered shutter 4 Key punched 7 Torch cut 10 Other (specify) .....						
SCREEN-PERFORATED INTERVALS:		From 122 ft. to 132 ft. From 197 ft. to 212 ft.				
		From 136 ft. to 151 ft. From 226 ft. to 251 ft.				
GRAVEL PACK INTERVALS:		From 20 ft. to 256 ft. From .... ft. to .... ft.				
		From .... ft. to .... ft. From .... ft. to .... ft.				
6 GROUT MATERIAL:		1 Neat cement 2 Cement grout 3 Bentonite 4 Other 48" square cement block				
Grout intervals: From 6 ft. to 20 ft. From .... ft. to .... ft. From 1' above ft. to 6 ft.						
What is the nearest source of possible contamination:		10 Livestock pens 14 Abandoned water well				
1 Septic tank 4 Lateral lines 7 Pit privy 11 Fuel storage 15 Oil well/Gas well						
2 Sewer lines 5 Cess pool 8 Sewage lagoon 12 Fertilizer storage 16 Other (specify below)						
3 Watertight sewer lines 6 Seepage pit 9 Feedyard 13 Insecticide storage None observed						
Direction from well?		How many feet?				
FROM	TO	LITHOLOGIC LOG	FROM	TO	PLUGGING INTERVALS	
0	5	Topsoil	152	162	Clay, gray and green	
5	16	Clay, reddish-brown	162	172	Clay, green, sand streaks	
16	41	Sand and gravel, fine, medium	172	182	Clay, gray	
41	45	Clay, blue	182	195	Clay, blue	
45	79	Sand and gravel, fine, medium,	195	202	Sand, fine and mixed clay	
		coarse	202	216	Sand and gravel, fine	
79	84	Clay, green	216	225	Sand and gravel, fine, clay streak	
84	92	Sand and gravel, fine, clay streaks	225	235	Sand and gravel, fine	
92	98	Sand and gravel, fine, very fine	235	240	Sand and gravel, fine and blue clay	
98	102	Clay, green	240	252	Sand and gravel, fine	
102	116	Clay, blue, some brown	252	256	Clay, blue, green	
116	122	Sand and gravel, fine,				
122	132	Sand and gravel, fine, green clay				
132	152	streak				
		Sand and gravel, fine				
7 CONTRACTOR'S OR LANDOWNER'S CERTIFICATION: This water well was (1) constructed, (2) reconstructed, or (3) plugged under my jurisdiction and was completed on (mo/day/year) 6-3-91 and this record is true to the best of my knowledge and belief. Kansas Water Well Contractor's License No. 185 This Water Well Record was completed on (mo/day/yr) 8-28-91 under the business name of Clarke Well & Equipment, Inc. by (signature) [Signature]						
INSTRUCTIONS: Use typewriter or ball point pen. PLEASE PRESS FIRMLY and PRINT clearly. Please fill in blanks, underline or circle the correct answers. Send top three copies to Kansas Department of Health and Environment, Bureau of Water, Topeka, Kansas 66620-0001. Telephone: 913-296-5545. Send one to WATER WELL OWNER and retain one for your records.						

OFFICE USE ONLY

T

R

EW

SEC.

1/4

1/4

1/4