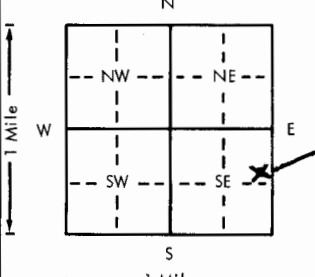


USE TYPEWRITER OR BALL
POINT PEN-PRESS FIRMLY,
PRINT CLEARLY.

WATER WELL RECORD
KSA 82a-1201-1215

Kansas Department of Health and
Environment-Division of Environment
(Water well Contractors)
Topeka, Kansas 66620

1. Location of well:	County HARVEY	Fraction SE 1/4 NE 1/4 SE 1/4	Section number 10	Township number T 24 S	Range number R 2 W
2. Distance and direction from nearest town or city: 2 1/2 South Street address of well location if in city: OF HALSTEAD, KS.			3. Owner of well: JAMES FEIN R.R. or street: RR. #2 City, state, zip code: HALSTEAD, KANSAS 67056		
4. Locate with "X" in section below: Sketch map: 1			6. Bore hole dia. 30 in. Completion date 4-26-79 Well depth 160 ft.		
			7. <input type="checkbox"/> Cable tool <input type="checkbox"/> Rotary <input type="checkbox"/> Driven <input type="checkbox"/> Dug <input type="checkbox"/> Hollow rod <input type="checkbox"/> Jetted <input type="checkbox"/> Bored <input checked="" type="checkbox"/> Reverse rotary		
			8. Use: <input type="checkbox"/> Domestic <input type="checkbox"/> Public supply <input type="checkbox"/> Industry <input checked="" type="checkbox"/> Irrigation <input type="checkbox"/> Air conditioning <input type="checkbox"/> Stock <input type="checkbox"/> Lawn <input type="checkbox"/> Oil field water <input type="checkbox"/> Other		
5. Type and color of material			9. Casing: Material TRANSITE Height: Above or below Threaded <input type="checkbox"/> Welded <input type="checkbox"/> Surface 36 in. RMP <input type="checkbox"/> PVC <input type="checkbox"/> Weight 32 lbs./ft. Dia. 16 in. to 82 ft. depth Wall Thickness: inches or Dia. 16 in. to 160 ft. depth gage No. -75 IN		
			10. Screen: Manufacturer's name AMORA TILE COMPANY Type TRANSITE Dia. 16" I.D. Slot/gauze 1/16 Length 57 ft Set between 82 ft. and 134 ft. Gravel pack? YES Size range of material 1/4" - 1/2"		
			11. Static water level: 32 ft. below land surface Date 4-26-79		
			12. Pumping level below land surfaces: ____ ft. after ____ hrs. pumping ____ g.p.m. ____ ft. after ____ hrs. pumping ____ g.p.m. Estimated maximum yield 1200-1400 g.p.m.		
			13. Water sample submitted: YES Size range of material 1/4" - 1/2"		
			14. Well head completion: 36 inches above grade		
			15. Well grouted? YES PUDLE CLAY With: <input type="checkbox"/> Neat cement <input type="checkbox"/> Bentonite <input type="checkbox"/> Concrete Depth: From 0 ft. to 20 ft.		
			16. Nearest source of possible contamination: 1 ft. NONE Direction WITHIN 1 MILE Well disinfected upon completion? <input type="checkbox"/> Yes <input checked="" type="checkbox"/> No		
			17. Pump: WESTERN LAND ROLLER Manufacturer's name 8m HP 50 Volts 480 Length of drop pipe 110 ft. capacity 1300 g.p.m. Type: <input type="checkbox"/> Submersible <input checked="" type="checkbox"/> Turbine <input type="checkbox"/> Jet <input type="checkbox"/> Reciprocating <input type="checkbox"/> Centrifugal <input type="checkbox"/> Other		
18. Elevation:			19. Remarks:		
Topography: <input type="checkbox"/> Hill <input type="checkbox"/> Slope <input checked="" type="checkbox"/> Upland <input type="checkbox"/> Valley			(Use a second sheet if needed)		
			20. Water well contractor's certification: This well was drilled under my jurisdiction and this report is true to the best of my knowledge and belief. PETERSON IRRIGATION License No. 138 Business name Box 150 LINDSBOROUGH, KS. Address Mike Peterson Date 5-19-79 Signed Authorized representative		