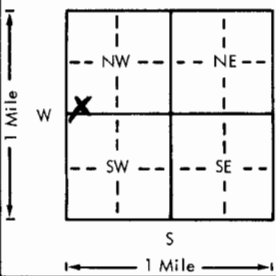
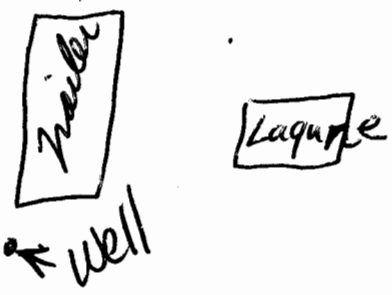


USE TYPEWRITER OR BALL
POINT PEN-PRESS FIRMLY,
PRINT CLEARLY.

WATER WELL RECORD
KSA 82a-1201-1215

Kansas Department of Health and
Environment-Division of Environment
(Water well Contractors)
Topeka, Kansas 66620

1. Location of well: County <u>Harvey</u> Fraction <u>SW 1/4 SW 1/4 NW 1/4</u> Section number <u>12</u> Township number <u>T 24 S</u> Range number <u>R 2 E</u>					
2. Distance and direction from nearest town or city: <u>1/2 S of Halstead KS.</u>		3. Owner of well: <u>Lonnie R. Martin</u> R.R. or street: <u>1648 Denver Dr.</u> City, state, zip code: <u>Wichita KS 67219</u>			
4. Locate with "X" in section below: 		Sketch map: 		6. Bore hole dia. <u>4</u> in. Completion date <u>10/26/78</u> Well depth <u>50</u> ft.	
5. Type and color of material		7. ☒ Cable tool ☒ Rotary ☐ Driven ☐ Dug ☐ Hollow rod ☐ Jetted ☐ Bored ☐ Reverse rotary			
		8. Use: ☒ Domestic ☐ Public supply ☐ Industry ☐ Irrigation ☐ Air conditioning ☐ Stock ☐ Lawn ☐ Oilfield water ☐ Other			
		9. Casing: Material <u>Steel</u> Height: Above or below Threaded ☐ Welded ☒ Surface <u>12</u> in. RMP ☒ PVC ☐ Weight <u>1.50</u> lbs./ft. Dia. <u>5</u> in. to <u>50</u> ft. depth Wall Thickness <u>200</u> inches or Dia. <u>5</u> in. to <u>50</u> ft. depth Gauge No. <u>200</u>			
		10. Screen: Manufacturer's name <u>Sunflower</u> Type <u>200</u> Dia. <u>5 in</u> Slot/gauze <u>1/16</u> Length <u>7 1/2</u> Set between <u>4</u> ft. and <u>480</u> ft. Gravel pack? <u>Yes</u> Size range of material <u>3/8</u>			
11. Static water level: <u>21</u> ft. below land surface Date <u>10/26/78</u>		12. Pumping level below land surfaces: <u>22</u> ft. after <u>1/2</u> hrs. pumping <u>15</u> g.p.m. <u> </u> ft. after <u> </u> hrs. pumping <u> </u> g.p.m. Estimated maximum yield <u>25</u> g.p.m.			
13. Water sample submitted: <u> </u> mo./day/yr. ☐ Yes ☒ No Date <u> </u>		14. Well head completion: <u> </u> Pitless adapter <u>12</u> inches above grade			
15. Well grouted? <u>Yes</u> With: <u> </u> Neat cement <u> </u> Bentonite ☒ Concrete Depth: From <u>3</u> ft. to <u>13</u> ft.		16. Nearest source of possible contamination: ft. <u>250</u> Direction <u>NW</u> Type <u>Leisure</u> Well disinfected upon completion? ☒ Yes ☐ No			
17. Pump: ☒ Not installed Manufacturer's name <u> </u> Model number <u> </u> HP <u> </u> Volts <u> </u> Length of drop pipe <u> </u> ft. capacity <u> </u> g.p.m. Type: ☐ Submersible ☐ Turbine ☐ Jet ☐ Reciprocating ☐ Centrifugal ☐ Other		18. Elevation: <u> </u>			
19. Remarks: <u>Customer to furnish 4'x4'x4'</u> <u>slab around well at grade</u> <u>Per State Regulations</u> <u>Signed X Lonnie R. Martin</u>		20. Water well contractor's certification: This well was drilled under my jurisdiction and this report is true to the best of my knowledge and belief. Business name <u>Harvey Miller</u> License No. <u>318</u> Address <u>Harvey KS</u> Signed <u> </u> Date <u>10/26/78</u> Authorized representative			