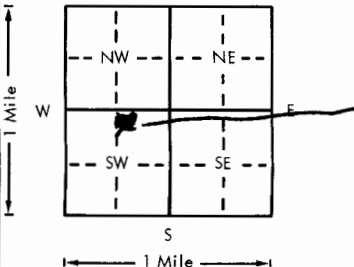


USE TYPEWRITER OR BALL
POINT PEN-PRESS FIRMLY,
PRINT CLEARLY.

WATER WELL RECORD
KSA 82a-1201-1215

Kansas Department of Health and
Environment-Division of Environment
(Water well Contractors)
Topeka, Kansas 66620

1. Location of well:		County HARVEY	Fraction NW 1/4 NE 1/4 SW 1/4	Section number 14	Township number T 24 S	Range number R 2 W
X Distance and direction from nearest town or city: 2 1/2 mi South		3. Owner of well: John Stutzman				
Street address of well location if in city: OF HALSTEAD, KS.		R.R. # 2 City, state, zip code: HALSTEAD, KS. 67056				
4. Locate with "X" in section below:		Sketch map:		6. Bore hole dia. 30 1/2 in. Completion date 4-30-79 Well depth 138 ft.		
				7. Cable tool ☐ Rotary ☐ Driven ☐ Dug ☐ Hollow rod ☐ Jetted ☐ Bored ☒ Reverse rotary		
5. Type and color of material		From	To	8. Use: Domestic ☐ Public supply ☐ Industry ☐ Irrigation ☒ Air conditioning ☐ Stock ☐ Lawn ☐ Oil field water ☐ Other ☐		
Top Soil		0	3	9. Casing: Material Steel Height Above or below Threaded ☐ Welded ☐ Surface 12 in. RMP ☐ PVC ☒ Weight ☐ lbs./ft. Dia. 1 1/2 in. to 79 ft. depth Wall Thickness: inches or Dia. ☐ in. to ☐ ft. depth gage No. 0.5 in.		
BROWN SANDY CLAY		3	12	10. Screen: Manufacturer's name JET STREAM PLASTICS Type PVC Dia. 1 1/2 Slot/gauze 1/16 Length 40 ft Set between 99 ft. and 139 ft. ft. and ☐ ft. Gravel pack? YES Size range of material 1/4 in		
VERY FINE SAND		12	20	11. Static water level: ☐ mo./day/yr. 32 ft. below land surface Date 4-20-79		
FINE AND MEDIUM SAND		20	25	12. Pumping level below land surfaces: ft. after ☐ hrs. pumping ☐ g.p.m. ft. after ☐ hrs. pumping ☐ g.p.m. Estimated maximum yield 1900 g.p.m.		
MEDIUM COURSE SAND		25	37	13. Water sample submitted: ☐ mo./day/yr. ☒ Yes ☐ No Date 4-30-79		
MEDIUM GRAY SAND		37	55	14. Well head completion: Pitless adapter 12 Inches above grade		
GRAY CLAY		55	62	15. Well grouted? YES POOR CLAY With: Neat cement ☐ Bentonite ☐ Concrete ☐ Depth: From 0 ft. to 15 ft.		
MEDIUM GRAY SAND		62	75	16. Nearest source of possible contamination: ft. None within 1 mile Type ☐ Well disinfected upon completion? ☐ Yes ☒ No		
FINE SAND & CLAY		75	91	17. Pump: ☐ Not installed Manufacturer's name WESTERN LAND PUMP Model number 87M HP 40 Volts ☐ Length of drop pipe 100 ft. capacity 1200 g.p.m. Type: ☐ Submersible ☒ Turbine ☐ Jet ☐ Reciprocating ☐ Centrifugal ☐ Other		
FINE SAND		91	112	20. Water well contractor's certification: This well was drilled under my jurisdiction and this report is true to the best of my knowledge and belief. PETERSON IRRIGATION 138 Business name License No. Address Box 150 LINDSBORG KS Signed Mike Peterson Date 5-11-79 Authorized representative		
GREEN CLAY		112	118			
MEDIUM EQUAS SANDS		118	138			
BLUE SHALE		138	139			
(Use a second sheet if needed)						
18. Elevation:		19. Remarks:				
Topography: ☐ Hill ☐ Slope ☒ Upland ☐ Valley						

24 21 14 NW 1/4 SE 1/4



REPORT OF INORGANIC WATER ANALYSIS

STATE OF KANSAS
DEPARTMENT OF HEALTH & ENVIRONMENT
OFFICE OF LABORATORIES AND RESEARCH
FORBES BLDG. 740, TOPEKA, KANSAS 66620

Address inquiries to:
Division of Environment
Mail samples to:
Environmental Laboratories

Wallace N. Peterson
Peterson Irrigation, Inc.

Lab. No. 1615

Acct. Oil Field

Copies To:
W. N. Peterson
Oil Field ✓
South Central Dist.
Mr. John Stutsman
Groundwater Manage-
ment Dist. #2,
c/o Thomas C. Bell,
Manager, 243 Main,
Halstead, Ks. 67056

mef
RECEIVED

MAR 29 1979

DIVISION OF ENVIRONMENT
OF & EG S&C.

LOCALITY Harvey County COLLECTED BY 331 Harrison, Lindsborg, Ks.
DATE COLLECTED 3/5/79 DATE REC'D 3/9/79 DATE REPORTED MAR 29 1979

Remarks:

Lab. No. 1615
Source: Mr. J. Stutsman
Route 2, Halstead, Ks.
NE $\frac{1}{4}$, NW $\frac{1}{4}$ SW $\frac{1}{4}$, Sec. 14
T24S, R2W, 150', Test
Well - Irrigation.

Lab. No. _____
Source: _____

Lab. No. _____
Source: _____

Results expressed in
Milligrams Per Liter

H				
Total Hardness (as CaCO ₃)	✓ 88.			
Calcium (Ca ⁺⁺)	✓ 27.			
Magnesium (Mg ⁺⁺)	✓ 5.0			
Sodium (Na ⁺)	✓ 16.			
Total Alkalinity (as CaCO ₃)	✓ 86.			
Chloride (Cl)	✓ 6.			
Sulfate (SO ₄)	✓ 28.			
Nitrate (as N)	✓ 0.0			
Fluoride (F)				
Iron				
Manganese				
.....				
.....				
.....				

FD *W.*

CD