



1 LOCATION OF WATER WELL: Fraction SW 1/4 SW 1/4 SE 1/4 Section Number 19 Township Number T 24 S Range Number R 2 SW
 County: Harvey
 Distance and direction from nearest town or city street address of well if located within city?

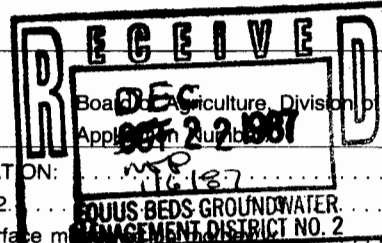

2 WATER WELL OWNER: Daniel E Weninger
 RR#, St. Address, Box #: RR1 Colwich Ks 67030
 City, State, ZIP Code

3 LOCATE WELL'S LOCATION WITH AN "X" IN SECTION BOX: 4 DEPTH OF COMPLETED WELL 50 ft. ELEVATION: 16187
 AN "X" IN SECTION BOX:

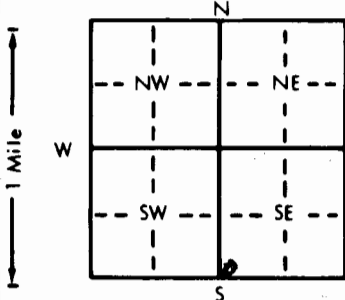




























What is the nearest source of possible contamination: 10 Livestock pens 14 Abandoned water well

1 Septic tank 4 Lateral lines 7 Pit privy 11 Fuel storage 15 Oil well/Gas well

2 Sewer lines 5 Cess pool 8 Sewage lagoon 12 Fertilizer storage 16 Other (specify below) 16

3 Watertight sewer lines 6 Seepage pit 9 Feedyard 13 Insecticide storage 16

Direction from well? West How many feet? 10

FROM TO LITHOLOGIC LOG FROM TO LITHOLOGIC LOG

FROM TO LITHOLOGIC LOG FROM TO LITHOLOGIC LOG

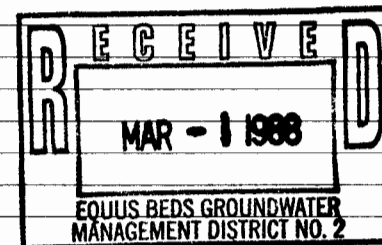

7 CONTRACTOR'S OR LANDOWNER'S CERTIFICATION: This water well was (1) constructed, (2) reconstructed, or (3) plugged under my jurisdiction and was completed on (mo/day/year) 9-15-87 and this record is true to the best of my knowledge and belief. Kansas

Water Well Contractor's License No. 9-15-87 This Water Well Record was completed on (mo/day/yr) X 2-20-88

under the business name of Daniel Weninger, Colwich Ks by (signature) Daniel E Weninger

INSTRUCTIONS: Use typewriter or ball point pen, PLEASE PRESS FIRMLY and PRINT clearly. Please fill in blanks, underline or circle the correct answers. Send top

three copies to Kansas Department of Health and Environment, Division of Environment, Environmental Geology Section, Topeka, KS 66620. Send one to WATER WELL

OWNER and retain one for your records.