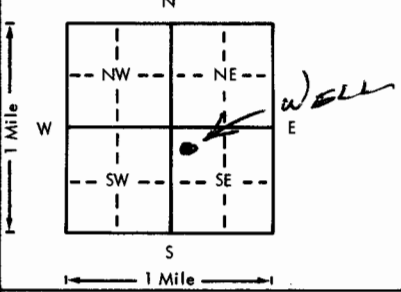


USE TYPEWRITER OR BALL
POINT PEN-PRESS FIRMLY,
PRINT CLEARLY.

WATER WELL RECORD
KSA 82a-1201-1215

Kansas Department of Health and
Environment-Division of Environment
(Water well Contractors)
Topeka, Kansas 66620

1. Location of well:		County HARVEY	Fraction NW NW SE SW NW NE 1/4	Section number 19	Township number T 24	Range number S R 2	(W)
2. Distance and direction from nearest town or city:		3 W at 350.		3. Owner of well: EUGENE WENONING			
Street address of well location if in city:		1 WEST HALSTEAD, KS		R.R. or street: RR 1			
				City, state, zip code: HALSTEAD, KANSAS			
4. Locate with "X" in section below:		Sketch map:		6. Bore hole dia. 30 in. Completion date 2-1-76			
				Well depth 105 ft.			
5. Type and color of material		From		To		7. ☐ Cable tool ☐ Rotary ☐ Driven ☐ Dug ☐ Hollow rod ☐ Jetted ☐ Bored ☒ Reverse rotary	
Top soil		0		3		8. Use: ☐ Domestic ☐ Public supply ☐ Industry ☒ Irrigation ☐ Air conditioning ☐ Stock ☐ Lawn ☐ Oil field water ☐ Other	
CLAY SILTY		3		11		9. Casing: Material TANKER Height: Above or below 0 MHC	
SAND - COARSE + GRAVEL		11		24		Threaded ☐ Welded ☐ Surface 12 in. RMP ☐ PVC ☐ Weight 32 lbs./ft.	
CLAY - BLUE		24		27		Dia. 16 in. to 105 ft. depth Wall Thickness: inches or Dia. 16 in. to 105 ft. depth Gauge No. 34	
SAND med. + GRAVEL		27		42		10. Screen: Manufacturer's name AUREA TIME CO	
CLAY GREEN		42		46		Type TRANSITE Dia. 16 " 10	
SAND - med.		46		57		Slot/gauze 1/8 Length 39	
CLAY - BLUE		57		59		Set between 46 ft. and 105 ft. Gravel pack? yes Size range of material 1/4 "	
SAND - med.		59		66		11. Static water level: 21 ft. below land surface Date 7-5-76	
CLAY - BLUE		66		72		12. Pumping level below land surfaces: 58 ft. after 2 hrs. pumping 1000 g.p.m. ft. after 4 hrs. pumping 1000 g.p.m. Estimated maximum yield 1200 g.p.m.	
SAND - FINE - Very		72		96		13. Water sample submitted: Yes ☒ No ☐ Date 7-5-76	
SAND - medium		96		105		14. Well head completion: ☐ Pitless adapter 12 inches above grade	
CLAY BLUE HARD		105		106		15. Well grouted? yes Puddled clay With: ☐ Neat cement ☐ Bentonite ☐ Concrete Depth: From 0 ft. to 10 ft.	
CASED 105 ft.						16. Nearest source of possible contamination: ft. 1300 Direction E Type Well Well disinfected upon completion? ☐ Yes ☒ No	
						17. Pump: Not installed Manufacturer's name Western Pump & Roller Model number 800 HP 30 Volts 480 Length of drop pipe 90 ft. capacity 1000 g.p.m. Type: ☐ Submersible ☒ Turbine ☐ Jet ☐ Reciprocating ☐ Centrifugal ☐ Other	
18. Elevation:		19. Remarks:		20. Water well contractor's certification: This well was drilled under my jurisdiction and this report is true to the best of my knowledge and belief. Peterson & Nighlin Inc 138A Business name Box 150 Lehigh, Kansas License No. 1-4-77 Address Waller, Kansas Signed Waller, Kansas Date 1-4-77 Authorized representative			