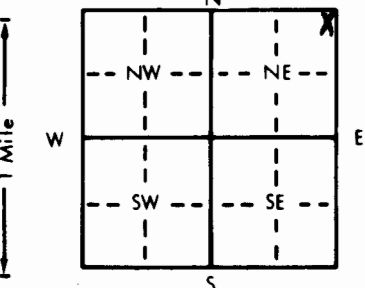


1 LOCATION OF WATER WELL:		Fraction	Section Number	Township Number	Range Number
County: <u>Harvey</u>		<u>NE 1/4</u> <u>NE 1/4</u> <u>NE 1/4</u>	<u>19</u>	<u>T 24</u> <u>S</u>	<u>R 2W</u> <u>E/W</u>
Distance and direction from nearest town or city street address of well if located within city?					
<u>4 miles N of Bentley and 3 mi. West, 1 M. N. Bentley, Kansas</u>					
2 WATER WELL OWNER: <u>Jerry Pomeroy</u>					
RR#, St. Address, Box # : <u>R.R. # 2 Box 74</u>					
City, State, ZIP Code : <u>Halstead, Ks.</u>					
Board of Agriculture, Division of Water Resources					
Application Number:					
3 LOCATE WELL'S LOCATION WITH AN "X" IN SECTION BOX:		4 DEPTH OF COMPLETED WELL: <u>50</u> ft. ELEVATION:			
		Depth(s) Groundwater Encountered 1. <u>34</u> ft. 2. <u>34</u> ft. 3. <u>34</u> ft.			
		WELL'S STATIC WATER LEVEL <u>34</u> ft. below land surface measured on <u>mo/day/yr</u> <u>7-19-89</u>			
		WELL WATER TO BE USED AS: 5 Public water supply 8 Air conditioning 11 Injection well			
		1 Domestic 3 Feedlot 6 Oil field water supply 9 Dewatering 12 Other (Specify below)			
		2 Irrigation 4 Industrial 7 Lawn and garden only 10 Monitoring well			
		Was a chemical/bacteriological sample submitted to Department? Yes <u>No</u> X; If yes, mo/day/yr sample was submitted			
		Water Well Disinfected? Yes <u>X</u> No			
5 TYPE OF BLANK CASING USED:					
1 Steel 3 RMP (SR) 5 Wrought iron 8 Concrete tile CASING JOINTS: Glued <u>X</u> Clamped					
2 PVC 4 ABS 6 Asbestos-Cement 9 Other (specify below) Welded					
Casing height above land surface <u>12</u> in., weight <u>1.59</u> lbs./ft. Wall thickness or gauge No. <u>203</u>					
TYPE OF SCREEN OR PERFORATION MATERIAL:					
1 Steel 3 Stainless steel 5 Fiberglass 7 PVC 10 Asbestos-cement					
2 Brass 4 Galvanized steel 6 Concrete tile 8 RMP (SR) 11 Other (specify)					
SCREEN OR PERFORATION OPENINGS ARE:					
1 Continuous slot 3 Mill slot 5 Gauzed wrapped 8 Saw cut 11 None (open hole)					
2 Louvered shutter 4 Key punched 6 Wire wrapped 9 Drilled holes					
7 Torch cut 10 Other (specify)					
6 GROUT MATERIAL: 1 Neat cement 2 Cement grout 3 Bentonite 4 Other					
What is the nearest source of possible contamination:					
1 Septic tank 4 Lateral lines 7 Pit privy 10 Livestock pens 14 Abandoned water well					
2 Sewer lines 5 Cess pool 8 Sewage lagoon 11 Fuel storage 15 Oil well/Gas well					
3 Watertight sewer lines 6 Seepage pit 9 Feedyard 12 Fertilizer storage 16 Other (specify below)					
13 Insecticide storage					
Direction from well? <u>Northwest</u> How many feet? <u>150</u>					
FROM TO LITHOLOGIC LOG FROM TO PLUGGING INTERVALS					
0 3 topsoil					
3 11 clay					
11 21 fine sand					
21 50 medium sand					
7 CONTRACTOR'S OR LANDOWNER'S CERTIFICATION: This water well was (1) constructed, (2) reconstructed, or (3) plugged under my jurisdiction and was completed on (mo/day/year) <u>7-19-89</u> and this record is true to the best of my knowledge and belief. Kansas					
Water Well Contractor's License No. <u>236</u> This Water Well Record was completed on (mo/day/yr) <u>10-16-89</u>					
under the business name of <u>Harp Well and Pump Service, Inc.</u> by (signature) <u>Mark Arnold</u>					