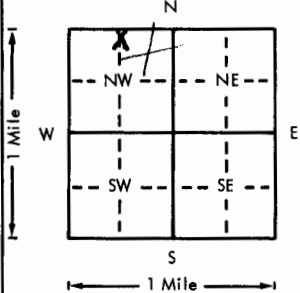


USE TYPEWRITER OR BALL
POINT PEN-PRESS FIRMLY,
PRINT CLEARLY.

WATER WELL RECORD
KSA 82a-1201-1215

Kansas Department of Health and
Environment-Division of Environment
(Water well Contractors)
Topeka, Kansas 66620

1. Location of well:		County: <u>Harvey</u>	Fraction: <u>1/4 NE 1/4 NW 1/4</u>	Section number: <u>24</u>	Township number: <u>T 24</u>	Range number: <u>S R 2 E NW</u>
2. Distance and direction from nearest town or city: <u>35. 1/4 E. of Habitat, Kansas</u>			3. Owner of well: <u>Bob Knowles</u> R.R. or street: <u>Route 3</u> City, state, zip code: <u>Hingman, Kansas</u>			
4. Locate with "X" in section below:			Sketch map:		6. Bore hole dia. <u>11</u> in. Completion date <u>8-27-15</u> Well depth <u>99</u> ft.	
					7. ☒ Cable tool ☒ Rotary ☐ Driven ☐ Dug ☐ Hollow rod ☐ Jetted ☐ Bored ☐ Reverse rotary	
					8. Use: ☒ Domestic ☐ Public supply ☐ Industry ☐ Irrigation ☐ Air conditioning ☐ Stock ☐ Lawn ☐ Oil field water ☐ Other	
5. Type and color of material			From	To	9. Casing: Material <u>staprene</u> Height: Above or below surface <u>12</u> in. Threaded ☒ Welded ☒ Surface <u>12</u> in. RMP ☒ PVC ☐ Weight <u>15</u> lbs./ft. Dia. <u>5</u> in. to <u>99</u> ft. depth Wall Thickness: inches or Dia. <u>5</u> in. to <u>99</u> ft. depth gage No. <u>20</u>	
<u>Sandy Soil</u>			<u>0</u>	<u>2</u>	10. Screen: Manufacturer's name <u>Sunflower</u> <u>Plastic</u> Type <u>staprene</u> Dia. <u>5</u> in. Slot/gauze <u>1,003</u> Length <u>15</u> ft. Set between <u>84</u> ft. and <u>99</u> ft. Gravel pack <u>yes</u> Size range of material <u>1/4-1/8"</u>	
<u>Black Clay</u>			<u>2</u>	<u>26</u>	11. Static water level: <u>25</u> ft. below land surface Date <u>8-27-15</u> mo./day/yr.	
<u>Fine Sand</u>			<u>26</u>	<u>35</u>	12. Pumping level below land surfaces: ____ ft. after ____ hrs. pumping ____ g.p.m. ____ ft. after ____ hrs. pumping ____ g.p.m. Estimated maximum yield ____ g.p.m.	
<u>Medium Sand</u>			<u>35</u>	<u>63</u>	13. Water sample submitted: ____ mo./day/yr. Yes ____ No ____ Date ____	
<u>Clay and white sand</u>			<u>63</u>	<u>75</u>	14. Well head completion: <u>12</u> capped ____ Pitless adapter ____ Inches above grade	
<u>Clay</u>			<u>75</u>	<u>90</u>	15. Well grouted? <u>yes</u> With: ☒ Neat cement ☐ Bestonite ☐ Concrete Depth: From <u>40 1/2</u> to <u>14</u> ft.	
<u>Medium Fine Sand</u>			<u>90</u>	<u>98</u>	16. Nearest source of possible contamination: <u>NONE</u> ft. ____ Direction ____ Type ____ Well disinfected upon completion? ☒ Yes ____ No	
<u>Coarse Sand</u>			<u>98</u>	<u>99</u>	17. Pump: ☒ Not installed Manufacturer's name ____ Model number ____ HP ____ Volts ____ Length of drop pipe ____ ft. capacity ____ g.p.m. Type: ____ Submersible ____ Turbine ____ Jet ____ Reciprocating ____ Centrifugal ____ Other	
(Use a second sheet if needed)						
18. Elevation:		19. Remarks: <u>Flat Ground</u> <u>Septic tank to be installed</u> <u>100 ft south of well.</u>			20. Water well contractor's certification: This well was drilled under my jurisdiction and this report is true to the best of my knowledge and belief. <u>Harv Mill & Pump 236</u> Business name <u>Wichita Kansas</u> License No. ____ Address <u>M. Arnold</u> Date <u>8-28-15</u> Signed <u>M. Arnold</u> Authorized representative	