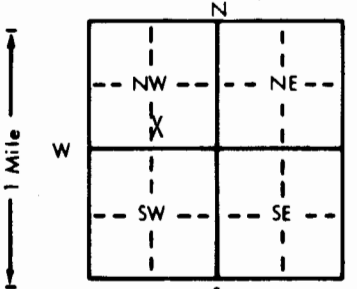


PLUGGING REPORT

WATER WELL RECORD

Form WWC-5

KSA 82a-1212

1 LOCATION OF WATER WELL:		Fraction	Section Number	Township Number	Range Number
County: <u>Harvey</u>		<u>NCO</u> <u>1/4</u> <u>S1/2</u> <u>1/4</u> <u>NW</u> <u>1/4</u>	<u>24</u>	<u>T 24</u> <u>S</u>	<u>R 2</u> <u>E/W</u>
Distance and direction from nearest town or city street address of well if located within city? <u>3 miles south and 1/4 mile east of Halstead, 3,300' north & 3,960' west of SE corner said section</u>					
2 WATER WELL OWNER: <u>Mrs. Robert Hensley</u>					
RR#, St. Address, Box #: <u>408 Locust</u>			Board of Agriculture, Division of Water Resources		
City, State, ZIP Code: <u>Halstead, Ks. 67056</u>			Application Number: <u>1110</u>		
3 LOCATE WELL'S LOCATION WITH AN "X" IN SECTION BOX:		4 DEPTH OF COMPLETED WELL: <u>60'</u> ft. ELEVATION: <u>UNK.</u>			
		Depth(s) Groundwater Encountered 1. <u>5 bls</u> ft. 2. ft. 3. ft.			
		WELL'S STATIC WATER LEVEL <u>5</u> ft. below land surface measured on mo/day/yr <u>12-12-90</u>			
		Pump test data: Well water was ft. after hours pumping gpm			
		Est. Yield gpm: Well water was ft. after hours pumping gpm			
Bore Hole Diameter in. to ft., and in. to ft.		WELL WATER TO BE USED AS:			
1 Domestic <u>WAS</u>		3 Feedlot		6 Oil field water supply	
* 2 Irrigation		4 Industrial		7 Lawn and garden only	
Was a chemical/bacteriological sample submitted to Department? Yes No		10 Monitoring well		11 Injection well	
mitted <u>1 gal. chlorox placed in well</u>		Water Well Disinfected? Yes <u>XX</u> No		12 Other (Specify below)	
5 TYPE OF BLANK CASING USED:					
* 1 Steel		3 RMP (SR)		5 Wrought iron	
2 PVC		4 ABS		6 Asbestos-Cement	
Blank casing diameter <u>.48</u> in. to <u>20</u> ft., Dia. <u>4</u> in. to <u>60</u> ft., Dia.		7 Fiberglass		* 9 Other (specify below)	
Casing height above land surface <u>10'</u> bls <u>XX</u> , weight lbs./ft.		8 Concrete tile		CASING JOINTS: Glued Clamped	
TYPE OF SCREEN OR PERFORATION MATERIAL:		7 PVC		Welded	
1 Steel		3 Stainless steel		10 Asbestos-cement	
2 Brass		4 Galvanized steel		11 Other (specify)	
SCREEN OR PERFORATION OPENINGS ARE:		5 Gauzed wrapped		8 Saw cut	
1 Continuous slot		6 Wire wrapped		11 None (open hole)	
2 Louvered shutter		7 Torch cut		9 Drilled holes	
SCREEN-PERFORATED INTERVALS: From ft. to ft., From ft. to ft., From ft. to ft., From ft. to ft.		10 Other (specify)		12 None used (open hole)	
GRAVEL PACK INTERVALS: From ft. to ft., From ft. to ft., From ft. to ft., From ft. to ft.					
6 GROUT MATERIAL: 1 Neat cement * 2 Cement grout * 3 Bentonite * 4 Other <u>Clay</u>					
Grout Intervals: From <u>24</u> ft. to <u>20</u> (3) ft., From <u>20</u> ft. to <u>10.5</u> (4) ft., From <u>10.5</u> ft. to <u>9</u> (2) ft.					
What is the nearest source of possible contamination: <u>None</u>					
1 Septic tank		4 Lateral lines		7 Pit privy	
2 Sewer lines		5 Cess pool		8 Sewage lagoon	
3 Watertight sewer lines		6 Seepage pit		9 Feedyard	
Direction from well?		How many feet?			
FROM	TO	LITHOLOGIC LOG	FROM	TO	PLUGGING INTERVALS
			<u>60</u>	<u>24</u>	<u>Open casing-obstruction at 25'</u>
			<u>24</u>	<u>20</u>	<u>Hole Plug 1.0 cubic foot</u>
			<u>20</u>	<u>10.5</u>	<u>Clay 152 cubic feet</u>
			<u>10.5</u>	<u>9.5</u>	<u>Cement grout 1.5 cubic yard</u>
Plugging was witnessed by <u>Michael T. Dealy, Manager, Equus Beds Groundwater Management District No. 2</u>					
7 CONTRACTOR'S OR LANDOWNER'S CERTIFICATION: This water well was (1) constructed, (2) reconstructed, or (3) plugged under my jurisdiction and was completed on (mo/day/year) <u>12-14-90</u> and this record is true to the best of my knowledge and belief. Kansas					
Water Well Contractor's License No. <u>N/A</u> This Water Well Record was completed on (mo/day/yr) <u>12-14-90</u>					
under the business name of by (signature) <u>X Mrs. Robert Hensley</u>					

INSTRUCTIONS: Use typewriter or ball point pen. PLEASE PRESS FIRMLY and PRINT clearly. Please fill in blanks, underline or circle the correct answers. Send top three copies to Kansas Department of Health and Environment, Bureau of Water Protection, Topeka, Kansas 66620-7320. Telephone: 913-296-5514. Send one to WATER WELL OWNER and retain one for your records.