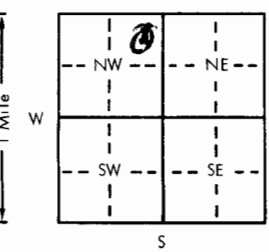
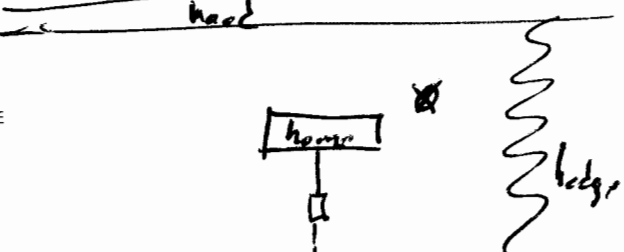


1. Location of well:		County HARVEY	Fraction NE 1/4 NE 1/4 NW 1/4	Section number 24	Township number T 24	Range number S R 2
2. Distance and direction from nearest town or city: Street address of well location if in city:		3 South 1/2 E of Halsted		3. Owner of well: R.R. or street: City, state, zip code:		
4. Locate with "X" in section below:		Sketch map:		6. Bore hole dia. 11 in. Completion date 4/12/78 Well depth 45 ft.		
				7. ☒ Cable tool ☒ Rotary ☐ Driven ☐ Dug ☐ Hollow rod ☐ Jetted ☐ Bored ☐ Reverse rotary		
5. Type and color of material		From		To		8. Use: ☒ Domestic ☐ Public supply ☐ Industry ☐ Irrigation ☐ Air conditioning ☐ Stock ☐ Lawn ☐ Oil field water ☐ Other
Loam to Brown clay		0		5		9. Casing: Material plastic Height above or below Threaded ☐ Welded ☐ Surface 18 in. RMP ☐ PVC ☒ Weight 2.82 lbs./ft. Dia. 5 in. to 45 ft. depth Wall Thickness: inches or Dia. ☐ in. to ☐ ft. depth Gauge No. 258
Brown clay		5		10		10. Screen: Manufacturer's name Owens Slot - Peerless P Type PVC Dia. 5 1/4 Slot/gauze .046 Length 20' Set between 25 ft. and 45 ft. Gravel pack? ☒ Size range of material 1/8" / 1/4"
Dark Black clay		10		12		11. Static water level: 18' ft. below land surface Date 4/13/78
" " " to Brown		12		15		12. Pumping level below land surfaces: 23 ft. after 1 hrs. pumping 20 g.p.m. ft. after ☐ hrs. pumping ☐ g.p.m. Estimated maximum yield 20/40 g.p.m.
" Brown clay		15		20		13. Water sample submitted: ☐ Yes ☒ No Date ☐
Grey - green clay		20		25		14. Well head completion: ☐ Pitless adapter 18 inches above grade
MED - coarse Brown sand		25		25		15. Well grouted? No With: ☐ Neat cement ☐ Bentonite ☐ Concrete Depth: From ☐ ft. to ☐ ft.
Coarse - gravel		35		40		16. Nearest source of possible contamination: ft. 70 Direction SW Type sewer Well disinfected upon completion? ☒ Yes ☐ No
Gravel		40		45		17. Pump: ☒ Not installed Manufacturer's name ☐ Model number ☐ HP ☐ Volts ☐ Length of drop pipe ☐ ft. capacity ☐ g.p.m. Type: ☐ Submersible ☐ Turbine ☐ Jet ☐ Reciprocating ☐ Centrifugal ☐ Other
25' (water sands)						18. Elevation:
(Use a second sheet if needed)						19. Remarks: X owner to grant well & install pump
