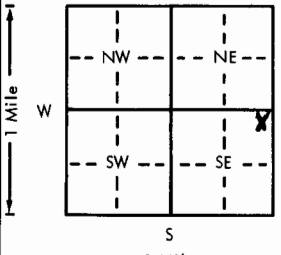
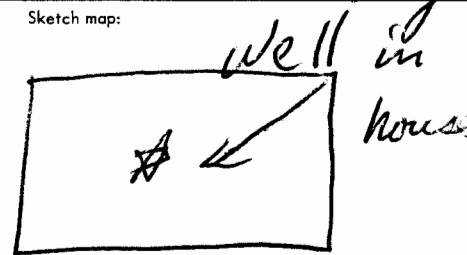


USE TYPEWRITER OR BALL  
POINT PEN-PRESS FIRMLY,  
PRINT CLEARLY.

WATER WELL RECORD  
KSA 82a-1201-1215

Kansas Department of Health and  
Environment-Division of Environment  
(Water well Contractors)  
Topeka, Kansas 66620

1. Location of well:	County: <u>HARVEY.</u>	Fraction: <u>NE 1/4 NE 1/4 SE 1/4</u>	Section number: <u>26</u>	Township number: <u>T 24</u>	Range number: <u>S 2 R 2</u>
2. Distance and direction from nearest town or city: <u>4 1/2 mile so Holstead Ks.</u>		3. Owner of well: <u>Paul Boerger</u> R.R. or street: <u>R#2</u> City, state, zip: <u>Judwich KS 67135</u>			
4. Locate with "X" in section below: 		Sketch map: 		6. Bore hole dia. <u>1 1/2</u> in. Completion date <u>1/30/78</u> Well depth <u>67</u> ft.	
5. Type and color of material		From	To	7. <input checked="" type="checkbox"/> Cable tool <input type="checkbox"/> Rotary <input type="checkbox"/> Driven <input type="checkbox"/> Dug <input type="checkbox"/> Hollow rod <input type="checkbox"/> Jetted <input type="checkbox"/> Bored <input type="checkbox"/> Reverse rotary	
<u>Top soil</u>		<u>0</u>	<u>4</u>	8. Use: <input checked="" type="checkbox"/> Domestic <input type="checkbox"/> Public supply <input type="checkbox"/> Industry <input type="checkbox"/> Irrigation <input type="checkbox"/> Air conditioning <input type="checkbox"/> Stock <input type="checkbox"/> Lawn <input type="checkbox"/> Oil field water <input type="checkbox"/> Other	
<u>fine sand</u>		<u>4</u>	<u>16</u>	9. Casing: Material <u>PVC</u> Height <u>Above</u> or below Threaded <input type="checkbox"/> Welded <input checked="" type="checkbox"/> Surface <u>12</u> in. RMP <input type="checkbox"/> PVC <input checked="" type="checkbox"/> Weight <u>2.86</u> lbs./ft. Dia. <u>5</u> in. to <u>67</u> ft. depth Wall Thickness: inches or Dia. <u>5</u> in. to <u>67</u> ft. depth gage No. <u>2.58</u>	
<u>red clay</u>		<u>16</u>	<u>20</u>	10. Screen: Manufacturer's name <u>M.P.I.</u> Type <u>PVC</u> Dia. <u>5 1/2</u> in. Slot gauge <u>1/16</u> Length <u>5 1/2</u> ft. Set between <u>35</u> ft. and <u>60</u> ft. ft. and <u>60</u> ft. Gravel pack? <u>Yes</u> Size range of material <u>3/8</u>	
<u>medium gravel</u>		<u>20</u>	<u>28</u>	11. Static water level: <u>26</u> ft. below land surface Date <u>1/30/78</u> mo./day/yr.	
<u>red clay</u>		<u>28</u>	<u>30</u>	12. Pumping level below land surfaces: <u>27</u> ft. after <u>12</u> hrs. pumping <u>20</u> g.p.m. ft. after <u>  </u> hrs. pumping <u>  </u> g.p.m. Estimated maximum yield <u>50</u> g.p.m.	
<u>medium gravel</u>		<u>30</u>	<u>48</u>	13. Water sample submitted: <u>  </u> mo./day/yr. <u>  </u> Yes <input checked="" type="checkbox"/> No <u>  </u> Date <u>  </u>	
<u>red clay</u>		<u>48</u>	<u>58</u>	14. Well head completion: <u>  </u> Pitless adapter <u>12</u> inches above grade	
<u>medium gravel</u>		<u>58</u>	<u>60</u>	15. Well grouted? <u>Yes</u> With: <u>  </u> Neat cement <u>  </u> Bentonite <input checked="" type="checkbox"/> Concrete Depth: From <u>6</u> ft. to <u>16</u> ft.	
<u>gray clay</u>		<u>60</u>	<u>67</u>	16. Nearest source of possible contamination: ft. <u>  </u> Direction <u>  </u> Type <u>  </u> Well disinfected upon completion? <input checked="" type="checkbox"/> Yes <u>  </u> No	
<u>fine sand</u>		<u>60</u>	<u>67</u>	17. Pump: <input checked="" type="checkbox"/> Not installed Manufacturer's name <u>  </u> Model number <u>  </u> HP <u>  </u> Volts <u>  </u> Length of drop pipe <u>  </u> ft. capacity <u>  </u> g.p.m. Type: <u>  </u> Submersible <u>  </u> Turbine <u>  </u> Jet <u>  </u> Reciprocating <u>  </u> Centrifugal <u>  </u> Other	
18. Elevation:		19. Remarks:		20. Water well contractor's certification: This well was drilled under my jurisdiction and this report is true to the best of my knowledge and belief. <u>Wenger</u> <u>Pulling</u> <u>318</u> Business name <u>  </u> License No. <u>  </u> Address <u>  </u> Signature <u>  </u> Date <u>  </u> Authorized representative <u>  </u>	