

1 LOCATION OF WATER WELL: Fraction NW 1/4 SW 1/4 NW 1/4 Section Number 27 Township Number T 24 S Range Number R 2 E
 County: HARVEY
 Distance and direction from nearest town or city street address of well if located within city? 2 W 4 So Halstead KS.

2 WATER WELL OWNER:

RR#, St. Address, Box #:

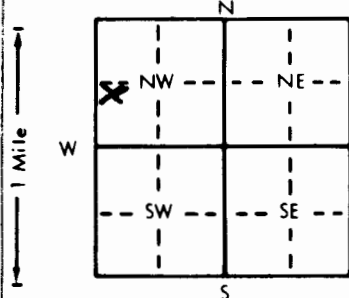
City, State, ZIP Code:

RON DECKERR#1 BX 196 HALSTEAD KS 67056

Board of Agriculture, Division of Water Resources

Application Number:

3 LOCATE WELL'S LOCATION WITH AN "X" IN SECTION BOX:

4 DEPTH OF COMPLETED WELL: 80 ft. ELEVATION:Depth(s) Groundwater Encountered 1. 47 ft. 2. 47 ft. 3. 10-11-90 ft.WELL'S STATIC WATER LEVEL 47 ft. below land surface measured on mo/day/yr 10-11-90Pump test data: Well water was 47 ft. after 2 hours pumping 20 gpmEst. Yield 40 gpm: Well water was 47 ft. after 2 hours pumping 20 gpmBore Hole Diameter: 11 in. to 80 ft., and 80 in. to 80 ft.

WELL WATER TO BE USED AS:

1 Domestic	3 Feedlot	6 Oil field water supply	9 Dewatering	12 Other (Specify below)
2 Irrigation	4 Industrial	7 Lawn and garden only	10 Monitoring well	

Was a chemical/bacteriological sample submitted to Department? Yes X No X; If yes, mo/day/yr sample was submittedWater Well Disinfected? Yes X No X

5 TYPE OF BLANK CASING USED:

1 Steel	3 RMP (SR)	5 Wrought iron	8 Concrete tile	CASING JOINTS: Glued <u>X</u> Clamped
2 PVC	4 ABS	6 Asbestos-Cement	9 Other (specify below)	Welded
		7 Fiberglass		Threaded

Blank casing diameter 5 in. to 60 ft., Dia 2.60 in. to 60 ft., Dia 160 PSI in. to 60 ft.Casing height above land surface 12 in., weight 2.60 lbs./ft. Wall thickness or gauge No. 160 PSI

TYPE OF SCREEN OR PERFORATION MATERIAL:

1 Steel	3 Stainless steel	5 Fiberglass	8 RMP (SR)	10 Asbestos-cement
2 Brass	4 Galvanized steel	6 Concrete tile	9 ABS	11 Other (specify)
				12 None used (open hole)

SCREEN OR PERFORATION OPENINGS ARE:

1 Continuous slot	3 Mill slot	5 Gauzed wrapped	8 Saw cut	11 None (open hole)
2 Louvered shutter	4 Key punched	6 Wire wrapped	9 Drilled holes	
		7 Torch cut	10 Other (specify)	

SCREEN-PERFORATED INTERVALS: From 60 ft. to 80 ft., From 60 ft. to 80 ft., From 60 ft. to 80 ft., From 60 ft. to 80 ft.GRAVEL PACK INTERVALS: From 23 ft. to 80 ft., From 23 ft. to 80 ft., From 23 ft. to 80 ft., From 23 ft. to 80 ft.

GROUT MATERIAL: 1 Neat cement 2 Cement grout 3 Bentonite 4 Other

Grout Intervals: From 3 ft. to 23 ft., From 3 ft. to 23 ft., From 3 ft. to 23 ft., From 3 ft. to 23 ft.

What is the nearest source of possible contamination:

1 Septic tank	4 Lateral lines	7 Pit privy	10 Livestock pens	14 Abandoned water well
2 Sewer lines	5 Cess pool	8 Sewage lagoon	11 Fuel storage	15 Oil well/Gas well
3 Watertight sewer lines	6 Seepage pit	9 Feedyard	12 Fertilizer storage	16 Other (specify below)
			13 Insecticide storage	

Direction from well? West How many feet? 120

FROM TO LITHOLOGIC LOG FROM TO PLUGGING INTERVALS

0	2	Top soi.			
2	27	CLAY			
27	34	SAND.			
34	47	clay			
47	80	fine to med SAND.			

CONTRACTOR'S OR LANDOWNER'S CERTIFICATION: This water well was (1) constructed (2) reconstructed, or (3) plugged under my jurisdiction and was completed on (mo/day/year) 10-11-90 and this record is true to the best of my knowledge and belief. KansasWater Well Contractor's License No. 318 This Water Well Record was completed on (mo/day/yr) NOV. 11, 90under the business name of Wenger Puller by (signature) [Signature]