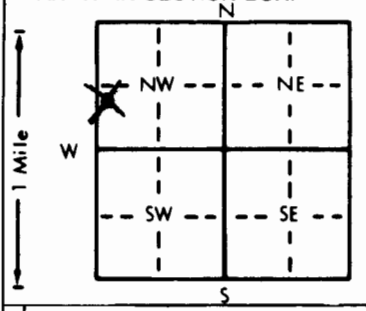


WATER WELL RECORD Form WWC-5 KSA 82a-1212

1 LOCATION OF WATER WELL:		Fraction	Section Number	Township Number	Range Number
County: <u>Harvey</u>		NW 1/4 SW 1/4 NW 1/4	28	T 24 S	R 2
Distance and direction from nearest town or city street address of well if located within city? <u>4 1/2 miles South & 2 miles West of Halstead, KS</u>					
2 WATER WELL OWNER: <u>Mrs. Irvin Decker</u>					
RR#, St. Address, Box # : <u>R.R. 2</u>			Board of Agriculture, Division of Water Resources		
City, State, ZIP Code : <u>Sedgwick, KS 67135</u>			Application Number:		
3 LOCATE WELL'S LOCATION WITH AN "X" IN SECTION BOX:		4 DEPTH OF COMPLETED WELL: <u>103</u> ft. ELEVATION:			
		Depth(s) Groundwater Encountered 1. <u>48</u> ft. 2. ft. 3. ft.			
		WELL'S STATIC WATER LEVEL <u>48</u> ft. below land surface measured on mo/day/yr <u>6-28-93</u> .			
		Pump test data: Well water was ft. after hours pumping gpm			
		Est. Yield <u>20-50</u> gpm: Well water was ft. after hours pumping gpm			
		Bore Hole Diameter <u>8</u> in. to <u>10.5</u> ft. and in. to ft.			
WELL WATER TO BE USED AS:		5 Public water supply 8 Air conditioning 11 Injection well			
1 Domestic 3 Feedlot 6 Oil field water supply 9 Dewatering 12 Other (Specify below)					
2 Irrigation 4 Industrial 7 Lawn and garden only 10 Monitoring well					
Was a chemical/bacteriological sample submitted to Department? Yes No <u>X</u> ; If yes, mo/day/yr sample was submitted					
Water Well Disinfected? Yes <u>X</u> No					
5 TYPE OF BLANK CASING USED:					
1 Steel 3 RMP (SR)		5 Wrought iron 8 Concrete tile		CASING JOINTS: Glued <u>X</u> Clamped	
2 PVC 4 ABS		6 Asbestos-Cement 9 Other (specify below)		Welded	
Blank casing diameter <u>5</u> in. to <u>9.3</u> ft. Dia		7 Fiberglass		Threaded	
Casing height above land surface <u>12</u> in. weight <u>2.37</u> lbs./ft. Wall thickness or gauge No. <u>21.4</u>					
TYPE OF SCREEN OR PERFORATION MATERIAL:					
1 Steel 3 Stainless steel 5 Fiberglass 7 PVC 10 Asbestos-cement					
2 Brass 4 Galvanized steel 6 Concrete tile 8 RMP (SR) 11 Other (specify)					
SCREEN OR PERFORATION OPENINGS ARE:		5 Gauzed wrapped 8 Saw cut 11 None (open hole)			
1 Continuous slot 3 Mill slot 6 Wire wrapped 9 Drilled holes					
2 Louvered shutter 4 Key punched 7 Torch cut 10 Other (specify)					
SCREEN-PERFORATED INTERVALS: From <u>9.3</u> ft. to <u>10.3</u> ft. From ft. to ft.					
GRAVEL PACK INTERVALS: From <u>2.5</u> ft. to <u>10.3</u> ft. From ft. to ft.					
6 GROUT MATERIAL: 1 Neat cement 2 Cement grout 3 Bentonite 4 Other					
Grout Intervals: From <u>5</u> ft. to <u>25</u> ft. From ft. to ft.					
What is the nearest source of possible contamination:					
1 Septic tank 4 Lateral lines 7 Pit privy 10 Livestock pens 14 Abandoned water well					
2 Sewer lines 5 Cess pool 8 Sewage lagoon 11 Fuel storage 15 Oil well/Gas well					
3 Watertight sewer lines 6 Seepage pit 9 Feedyard 12 Fertilizer storage 16 Other (specify below)					
Direction from well? <u>South</u>		How many feet? <u>100ft</u>			
FROM	TO	LITHOLOGIC LOG	FROM	TO	PLUGGING INTERVALS
0	4	Top Soil			
4	9	Silty Tan Clay			
9	18	Red Silty Clay			
18	52	Fine Brown Sand			
52	73	Medium Fine Brown Sand			
73	82	Green Clay			
82	102	Medium Fine Brown Sands			
102	105	Blue Clay			
7 CONTRACTOR'S OR LANDOWNER'S CERTIFICATION: This water well was (1) constructed, (2) reconstructed, or (3) plugged under my jurisdiction and was completed on (mo/day/year) <u>6-28-93</u> and this record is true to the best of my knowledge and belief. Kansas					
Water Well Contractor's License No. <u>138</u> This Water Well Record was completed on (mo/day/yr) <u>7-6-93</u>					
under the business name of <u>Peterson Irrigation Inc.</u> by (signature) <u>Mike Peterson</u>					

INSTRUCTIONS: Use typewriter or ball point pen. PLEASE PRESS FIRMLY and PRINT clearly. Please fill in blanks, underline or circle the correct answers. Send top three copies to Kansas Department of Health and Environment, Bureau of Water, Topeka, Kansas 66620-0001. Telephone: 913-296-5545. Send one to WATER WELL OWNER and retain one for your records.