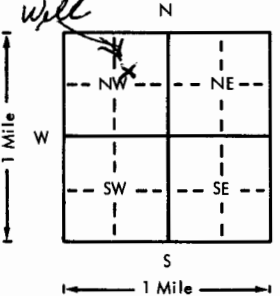
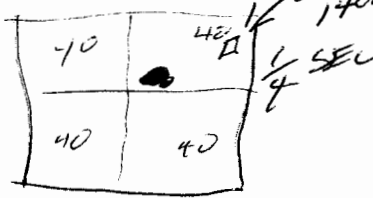


USE TYPEWRITER OR BALL
POINT PEN-PRESS FIRMLY,
PRINT CLEARLY.

WATER WELL RECORD
KSA 82a-1201-1215

Kansas Department of Health and
Environment-Division of Environment
(Water well Contractors)
Topeka, Kansas 66620

1. Location of well:	County <u>HARVEY</u>	Fraction <u>SW 1/4 NE 1/4 NW 1/4</u>	Section number <u>29</u>	Township number <u>T-24-S</u>	Range number <u>R-2-W</u>
2. Distance and direction from nearest town or city: <u>1W-4 1/2 S of Holstead</u>			3. Owner of well: <u>Willis DIRKS</u> R.R. or street: <u>R.R. Holstead, Kansas 67056</u> City, state, zip code:		
4. Locate with "X" in section below:		Sketch map:		6. Bore hole dia. <u>30</u> in. Completion date <u>12-15-75</u> Well depth <u>234</u> ft.	
				7. Cable tool ☐ Rotary ☐ Driven ☐ Dug ☐ Hollow rod ☐ Jetted ☐ Bored ☒ Reverse rotary	
5. Type and color of material		From To		8. Use: Domestic ☐ Public supply ☐ Industry ☐ ☒ Irrigation ☐ Air conditioning ☐ Stock ☐ Lawn ☐ Oil field water ☐ Other ☐	
Top soil		0 1		9. Casing: Material <u>transite</u> Height: Above or below Threaded ☐ Welded ☐ Surface ☐ in. RMP ☐ PVC ☐ Weight <u>75</u> lbs./ft. Dia. <u>16</u> in. to <u>234</u> ft. depth Wall Thickness: inches or Dia. <u>16</u> in. to <u>234</u> ft. depth gage No. <u>11</u>	
Clay DARK		1 7		10. Screen: Manufacturer's name <u>AURORA TILE CO.</u> Type <u>TRANSITE</u> Dia. <u>16</u> in. Slot/gauze <u>1/8</u> Length <u>164</u> Set between <u>138</u> ft. and <u>164</u> ft. <u>208</u> ft. and <u>234</u> ft. Gravel pack? <u>yes</u> Size range of material <u>1/4"</u>	
Clay - RED		7 23		11. Static water level: <u>26</u> ft. below land surface Date <u>12-16-75</u>	
WATER LOSS - GRAVEL - COARSE		23 71		12. Pumping level below land surfaces: ____ ft. after ____ hrs. pumping ____ g.p.m. ____ ft. after ____ hrs. pumping ____ g.p.m. Estimated maximum yield ____ g.p.m.	
Clay - GREY		71 93		13. Water sample submitted: ____ mo./day/yr. Yes ☐ No ☒ Date ____	
SAND - VERY FINE		93 135		14. Well head completion: ____ Pitless adapter <u>12"</u> inches above grade	
Water Loss - SAND - MEDIUM		135 168		15. Well grouted? <u>yes</u> With: Neat cement ☐ Bentonite ☒ Concrete ☐ Depth: From <u>0</u> ft. to <u>10</u> ft.	
Clay - BUFF		168 170		16. Nearest source of possible contamination: <u>Domestic</u> ft. <u>1500</u> Direction <u>SE</u> Type <u>well</u> Well disinfected upon completion? Yes ☐ No ☒	
Water Loss - SANDS - MEDIUM		170 185		17. Pump: ☒ Not installed Manufacturer's name ____ Model number ____ HP ____ Volts ____ Length of drop pipe ____ ft. capacity ____ g.p.m. Type: ____ Submersible ☒ Turbine ☐ ____ Jet ☐ Reciprocating ☐ ____ Centrifugal ☐ Other ☐	
Clay - GREY		185 210		20. Water well contractor's certification: This well was drilled under my jurisdiction and this report is true to the best of my knowledge and belief. <u>Peterman Bros Inc 138</u> Business name License No. ____ Address <u>Lawrenceburg, Kansas</u> Signed <u>Wally Peterman</u> Date <u>12-22</u> Authorized representative	
Water Loss - SAND - MEDIUM		210 234			
Cased 234 ft.					
(Use a second sheet if needed)					
18. Elevation:	19. Remarks: <u>Well in for Center Pivot</u>		20. Water well contractor's certification:		
Topography: ☐ Hill ☒ Slope ☐ Upland ☐ Valley					