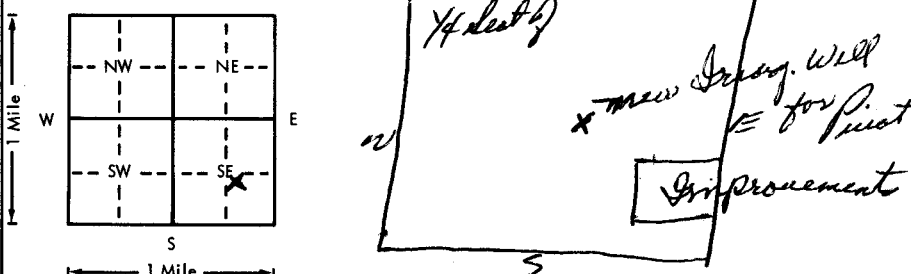


USE TYPEWRITER OR BALL
POINT PEN-PRESS FIRMLY,
PRINT CLEARLY.

WATER WELL RECORD
KSA 82a-1201-1215

Kansas Department of Health and
Environment-Division of Environment
(Water well Contractors)
Topeka, Kansas 66620

1. Location of well: County <u>Harvey</u> Fraction <u>NW 1/4 SE 1/4 SE 1/4</u> Section number <u>29</u> Township number <u>T 24 S R 2</u> Range number <u>EW</u>	
2. Distance and direction from nearest town or city: <u>2 W 4 3/4 S</u> Street address of well location if in city: <u>2 Sedgwick, Ks.</u>	
3. Owner of well: <u>Edward Dirks</u> R.R. or street: <u>R.R. 2</u> City, state, zip code: <u>Sedgwick, Kans. 67135</u>	
4. Locate with "X" in section below: Sketch map: <u>N</u> 	
5. Type and color of material	
<table border="1"><thead><tr><th></th><th>From</th><th>To</th></tr></thead><tbody><tr><td><u>Top Soil</u></td><td><u>0</u></td><td><u>1</u></td></tr><tr><td><u>Light yellow Clay & fine sands</u></td><td><u>1</u></td><td><u>9</u></td></tr><tr><td><u>Red sandy Clay</u></td><td><u>9</u></td><td><u>12</u></td></tr><tr><td><u>Yell Buff clays</u></td><td><u>12</u></td><td><u>15</u></td></tr><tr><td><u>Very fine sands - loose</u></td><td><u>15</u></td><td><u>22</u></td></tr><tr><td><u>Fine to med sands - loose</u></td><td><u>22</u></td><td><u>27</u></td></tr><tr><td><u>Dark Clay</u></td><td><u>27</u></td><td><u>29</u></td></tr><tr><td><u>Med sands & gravel</u></td><td><u>29</u></td><td><u>34</u></td></tr><tr><td><u>Blue gray Clay</u></td><td><u>34</u></td><td><u>42</u></td></tr><tr><td><u>Lime rock</u></td><td><u>42</u></td><td><u>45</u></td></tr><tr><td><u>Green & Buff Clays</u></td><td><u>45</u></td><td><u>52</u></td></tr><tr><td><u>Very fine sands & Clay lenses</u></td><td><u>52</u></td><td><u>76</u></td></tr><tr><td><u>Fine to med sand & gravel</u></td><td><u>76</u></td><td><u>123</u></td></tr><tr><td><u>Blue Clay</u></td><td><u>123</u></td><td><u>135</u></td></tr><tr><td><u>Coars sands - Clean</u></td><td><u>135</u></td><td><u>167</u></td></tr><tr><td><u>Dark Clay</u></td><td><u>167</u></td><td><u>182</u></td></tr><tr><td><u>Coars sands - Clean</u></td><td><u>182</u></td><td><u>218</u></td></tr>
19. Remarks: <u>Drift Hard Clays 218-222</u> <u>Fracture well for Private System</u> <u>Cont'd of 74 sheet.</u> <u>Customer will pump a slab around well.</u>	
20. Water well contractor's certification: This well was drilled under my jurisdiction and this report is true to the best of my knowledge and belief. Business name: <u>Peterson Bros Inc</u> License No. <u>138</u> Address: <u>Box 150 Lindbergh Kans</u> Signed: <u>Wally Peterson</u> Date: <u>12-9-75</u> Authorized representative	