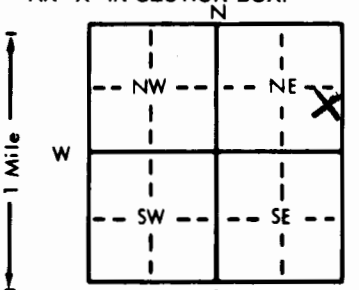


1 LOCATION OF WATER WELL:		Fraction	Section Number	Township Number	Range Number
County: <u>Harvey</u>		NE 1/4 SE 1/4 NE 1/4	29	T 24 S	R 2
Distance and direction from nearest town or city street address of well if located within city? <u>4 1/4 miles South & 3 miles West of Halstead, KS</u>					
2 WATER WELL OWNER: <u>Jerry Morris</u>					
RR#, St. Address, Box # : <u>RR 2</u> Board of Agriculture, Division of Water Resources					
City, State, ZIP Code : <u>Sedgwick, KS 67135</u> Application Number:					
3 LOCATE WELL'S LOCATION WITH AN "X" IN SECTION BOX:		4 DEPTH OF COMPLETED WELL <u>88</u> ft. ELEVATION:			
		Depth(s) Groundwater Encountered <u>1</u> <u>32</u> ft. 2. ft. 3. ft.			
		WELL'S STATIC WATER LEVEL <u>32</u> ft. below land surface measured on <u>mo/day/yr</u> <u>11-1-88</u>			
		Pump test data: Well water was _____ ft. after _____ hours pumping _____ gpm			
		Est. Yield <u>30-50</u> gpm: Well water was _____ ft. after _____ hours pumping _____ gpm			
		Bore Hole Diameter <u>8</u> in. to <u>88</u> ft. and _____ in. to _____ ft.			
		WELL WATER TO BE USED AS: 5 Public water supply 8 Air conditioning 11 Injection well			
		1 Domestic 3 Feedlot 6 Oil field water supply 9 Dewatering 12 Other (Specify below)			
		2 Irrigation 4 Industrial 7 Lawn and garden only 10 Observation well			
		Was a chemical/bacteriological sample submitted to Department? Yes _____ No <u>X</u> ; If yes, mo/day/yr sample was submitted _____			
		Water Well Disinfected? Yes <u>X</u> No _____			
5 TYPE OF BLANK CASING USED:					
1 Steel 3 RMP (SR) 5 Wrought iron 8 Concrete tile CASING JOINTS: <u>Glued</u> _____ Clamped _____					
2 PVC 4 ABS 6 Asbestos-Cement 9 Other (specify below) _____ Welded _____					
Blank casing diameter <u>5</u> in. to <u>78</u> ft. Dia _____ in. to _____ ft. Dia _____ in. to _____ ft.					
Casing height above land surface <u>12</u> in. weight <u>2.91</u> lbs./ft. Wall thickness or gauge No. <u>265</u>					
TYPE OF SCREEN OR PERFORATION MATERIAL:					
1 Steel 3 Stainless steel 5 Fiberglass 7 PVC 10 Asbestos-cement					
2 Brass 4 Galvanized steel 6 Concrete tile 8 RMP (SR) 11 Other (specify) _____					
SCREEN OR PERFORATION OPENINGS ARE:					
1 Continuous slot 3 Mill slot 5 Gauzed wrapped 8 Saw cut 11 None (open hole)					
2 Louvered shutter 4 Key punched 6 Wire wrapped 9 Drilled holes					
7 Torch cut 10 Other (specify) _____					
SCREEN-PERFORATED INTERVALS: From <u>78</u> ft. to <u>88</u> ft. From _____ ft. to _____ ft.					
GRAVEL PACK INTERVALS: From <u>25</u> ft. to <u>88</u> ft. From _____ ft. to _____ ft.					
6 GROUT MATERIAL: 1 Neat cement 2 <u>Cement grout</u> 3 Bentonite 4 Other _____					
Grout intervals: From <u>5</u> ft. to <u>25</u> ft. From _____ ft. to _____ ft. From _____ ft. to _____ ft.					
What is the nearest source of possible contamination:					
1 <u>Septic tank</u> 4 Lateral lines 7 Pit privy 10 Livestock pens 14 Abandoned water well					
2 Sewer lines 5 Cess pool 8 Sewage lagoon 11 Fuel storage 15 Oil well/Gas well					
3 Watertight sewer lines 6 Seepage pit 9 Feedyard 12 Fertilizer storage 16 Other (specify below) _____					
13 Insecticide storage _____					
Direction from well? <u>East</u> How many feet? <u>75</u>					
LITHOLOGIC LOG					
FROM	TO	LITHOLOGIC LOG	FROM	TO	LITHOLOGIC LOG
0	2	Sandy Top Soil			
2	7	Clay			
7	8	Sandrock			
8	16	Gray Clay			
16	23	Red Clay			
23	27	Gray Clay			
27	40	Coarse Sands			
40	51	Clays			
51	62	Sand			
62	65	Clay			
65	86	Sand--Light Brown			
86	88	Clay			
7 CONTRACTOR'S OR LANDOWNER'S CERTIFICATION: This water well was (1) <u>constructed</u> , (2) reconstructed, or (3) plugged under my jurisdiction and was completed on (mo/day/year) <u>11-1-88</u> and this record is true to the best of my knowledge and belief. Kansas					
Water Well Contractor's License No. <u>138</u> This Water Well Record was completed on (mo/day/yr) <u>11-1-88</u>					
under the business name of <u>Peterson Irrigation, Inc.</u> by (signature) <u>Mike Peterson</u>					
INSTRUCTIONS: Use typewriter or ball point pen. PLEASE PRESS FIRMLY and PRINT clearly. Please fill in blanks, underline or circle the correct answers. Send top three copies to Kansas Department of Health and Environment, Bureau of Water Protection, Topeka, Kansas 66620-7320, Telephone: 913-862-9360. Send one to WATER WELL OWNER and retain one for your records.					