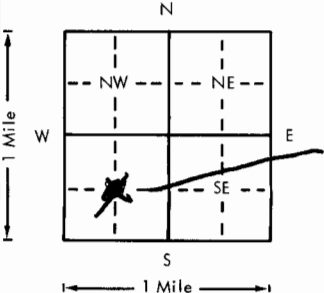


USE TYPEWRITER OR BALL
POINT PEN-PRESS FIRMLY,
PRINT CLEARLY.

WATER WELL RECORD
KSA 82a-1201-1215

Kansas Department of Health and
Environment-Division of Environment
(Water well Contractors)
Topeka, Kansas 66620

1. Location of well:		County: HARVEY	Fraction: Center 1/4 SW 1/4	Section number: 29	Township number: T 24 S R 2	Range number: 2
2. Distance and direction from nearest town or city: 3 1/2 mi North		3. Owner of well: HAROLD HEGE				
Street address of well location if in city: OF Bently, Ks.		R.R. or street: R.R. #2				
City, state, zip code: SEEDGEWICK, Ks. 67135						
4. Locate with "X" in section below:		Sketch map:		6. Bore hole dia. 30 in. Completion date: 6-7-79		
				Well depth 117 ft.		
5. Type and color of material		From	To	7. Cable tool ☐ Rotary ☐ Driven ☐ Dug ☐ Hollow rod ☐ Jetted ☐ Bored ☒ Reverse rotary		
Top Soil		0	4	8. Use: ☐ Domestic ☐ Public supply ☐ Industry ☒ Irrigation ☐ Air conditioning ☐ Stock ☐ Lawn ☐ Oil field water ☐ Other		
Brown Clay		4	12	9. Casing: Material TRANSITE Weight: 12 lbs./ft. Threading: Welded Surface: 12 in. RMP: PVC Weight: 32 lbs./ft. Dia. 16 in. to 65 ft. depth Wall Thickness: 1/2 in. Dia. 16 in. to 65 ft. depth Gauge No. 75 in		
MEDIUM COURSE SAND		12	20	10. Screen: Manufacturer's name AURORA PIPE COMPANY Type TRANSITE Dia. 16" I.D. Slot/gauze 1/8" Length 52 ft. Set between 65 ft. and 117 ft. Gravel pack? Yes Size range of material 4 in		
MEDIUM COURSE GRAY SAND		20	41	11. Static water level: 21 ft. below land surface Date 6-7-79		
GREEN SANDY CLAY		41	45	12. Pumping level below land surfaces: 12 inches above grade		
FINE SAND & CLAY		45	52	13. Water sample submitted: Yes ☒ No ☐ Date		
FINE SAND		52	65	14. Well head completion: 12 inches above grade		
GREEN CLAY MED. COURSE SAND		65	72	15. Well grouted? PEBBLE CLAY		
FINE SAND FINE SAND		72	85	With: ☐ Neat cement ☐ Bentonite ☐ Concrete		
MEDIUM COURSE SAND GREEN CLAY		85	88	Depth: From 0 ft. to 15 ft.		
GREEN CLAY FINE SAND		88	105	16. Nearest source of possible contamination: NONE		
MEDIUM COURSE SAND		105	117	ft. Within 1 mi. Type None		
GRAY CLAY		117	119	Well disinfected upon completion? ☐ Yes ☐ No		
				17. Pump: Not installed		
				Manufacturer's name WESTERN HAND ROLLER		
				Model number 8M HP 60 Volts		
				Length of drop pipe 30 ft. capacity 1000 g.p.m.		
				Type: ☐ Submersible ☒ Turbine ☐ Jet ☐ Reciprocating ☐ Centrifugal ☐ Other		
18. Elevation:		19. Remarks:		20. Water well contractor's certification:		
Topography: ☐ Hill ☐ Slope ☒ Upland ☐ Valley				This well was drilled under my jurisdiction and this report is true to the best of my knowledge and belief.		
				Business name PETERSON IRRIGATION License No. 138		
				Address Box 150 LINDSBURG KS		
				Signed Mike Peterson Date 7-14-79		
				Authorized representative		