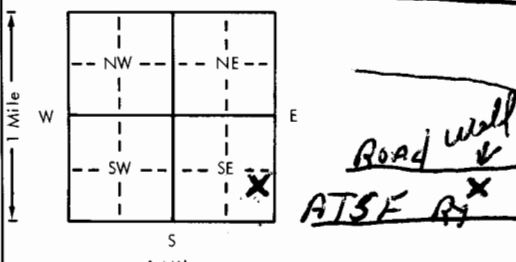


USE TYPEWRITER OR BALL
POINT PEN-PRESS FIRMLY,
PRINT CLEARLY.

WATER WELL RECORD
KSA 82a-1201-1215

Kansas Department of Health and
Environment-Division of Environment
(Water well Contractors)
Topeka, Kansas 66620

1. Location of well: County <u>HARVEY</u> Fraction <u>NE 1/4 SE 1/4 SE 1/4</u> Section number <u>34</u> Township number <u>T 24</u> Range number <u>S R 2</u> <u>N/W</u>	
2. Distance and direction from nearest town or city: <u>1 mi West</u> Street address of well location if in city: <u>OF HALSTEAD</u>	
3. Owner of well: <u>TOM ARNOLD</u> R.R. or street: <u>3205 Weesey</u> City, state, zip code: <u>HALSTEAD KS</u>	
4. Locate with "X" in section below: Sketch map: <u>N 1/4 W 1/4 S 50</u>	
	
5. Type and color of material	
From To	
<u>TOP</u> <u>0</u> <u>2</u>	
<u>CLAY Red</u> <u>2</u> <u>30</u>	
<u>FINE SAND BLACK</u> <u>30</u> <u>40</u>	
<u>SAND FINE TO COARSE</u> <u>40</u> <u>52</u>	
6. Bore hole dia. <u>10</u> in. Completion date: <u>10-27-78</u> Well depth <u>52</u> ft.	
7. ☒ Cable tool ☒ Rotary ☐ Driven ☐ Dug ☐ Hollow rod ☐ Jetted ☐ Bored ☐ Reverse rotary	
8. Use: ☐ Domestic ☐ Public supply ☐ Industry ☒ Irrigation ☐ Air conditioning ☐ Stock ☐ Lawn ☐ Oil field water ☐ Other	
9. Casing: Material <u>PITS</u> Height: Above or below <u>18</u> in. Threading: <u>Welded</u> Surface <u>18</u> in. RMP ☒ PVC ☐ Weight <u>1.50</u> lbs./ft. Dia. <u>5</u> in. to <u>52</u> ft. depth Wall Thickness: inches or <u>1/2</u> in. to <u>200</u> ft. depth	
10. Screen: Manufacturer's name <u>J & L</u> Type <u>RMP</u> Dia. <u>5</u> Slot/gauze <u>1/2</u> Length <u>20</u> Set between <u>32</u> ft. and <u>52</u> ft. Gravel pack? <u>yes</u> Size range of material <u>18-24</u>	
11. Static water level: <u>25</u> ft. below land surface Date <u>10-27-78</u> mo./day/yr.	
12. Pumping level below land surfaces: <u>25</u> ft. after <u>1</u> hrs. pumping <u>20</u> g.p.m. <u>50</u> g.p.m. Estimated maximum yield <u>50</u> g.p.m.	
13. Water sample submitted: <u>yes</u> ☒ Yes ☐ No Date <u>10-27-78</u> mo./day/yr.	
14. Well head completion: <u>18</u> inches above grade ☐ Pitless adapter ☒ Pitless adapter	
15. Well grouted? <u>yes</u> With: ☒ Neat cement ☐ Bentonite ☐ Concrete Depth: From <u>52</u> ft. to <u>52</u> ft.	
16. Nearest source of possible contamination: <u>200</u> ft. Direction <u>E</u> Type <u>City Sewer</u> Well disinfected upon completion? ☒ Yes ☐ No	
17. Pump: ☒ Not installed Manufacturer's name <u>DR Well Service</u> Model number <u>211</u> HP <u>1/2</u> Volts <u>115</u> Length of drop pipe <u>428</u> ft. capacity <u>3</u> g.p.m. Type: ☐ Submersible ☐ Turbine ☐ Jet ☐ Reciprocating ☐ Centrifugal ☐ Other	
18. Elevation: 19. Remarks: (Use a second sheet if needed)	
20. Water well contractor's certification: This well was drilled under my jurisdiction and this report is true to the best of my knowledge and belief. <u>DR Well Service</u> Business name <u>428 W 3rd Newton KS</u> Address <u>11-1-78</u> Date <u>11-1-78</u> Signature <u>W. J. Williams</u> Authorized representative	