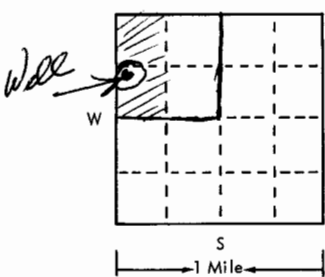


USE TYPEWRITER OR BALL
POINT PEN-PRESS FIRMLY,
PRINT CLEARLY.

WATER WELL RECORD
KSA 82a-1201-1215

T R EW sec 1/4 1/4 1/4 No.

Kansas State Dept. Of Health
(Water Well Contractors)
Forbes-Bldg. 740
Topeka, Kansas 66620

1 Location of well:	County HARVEY	Township name LAKIN	Fraction NW 1/4	Section number 35	Town number 24S	Range number R-2W
Distance and direction from nearest town or city:	5 SO. OF HALSTEAD			3 Owner of well:	John Henry ESTATE	
Street address of well location if in city:	165			Address:	June Lowe 143 S 4th Salina Kansas 674	
Locate with "X" in section below:	Sketch map:			4 Well depth: 87 ft. Date of completion 10-27-15 Well diameter _____ in. 10 27-15		
				5 ☐ Cable tool ☐ Rotary ☐ Driven ☐ Dug ☐ Hollow rod ☐ Jetted ☐ Bored ☒ Reverse rotary		
				6 Use: ☐ Domestic ☐ Public supply ☐ Industry ☒ Irrigation ☐ Air conditioning ☐ Commercial ☐ Test well ☐		
				7 Casing: Material TRANSITE Height: above/below Threaded ☐ Welded ☐ Surface 12 in. Diam. _____ Weight _____ lbs./ft. _____ 16 in. to 87 ft. depth Drive shoe? ☐ Yes ☐ No _____ in. to _____ ft. depth		
2	Type and color of material	From	To	8 Screen: Manufacturer AURORA TILE CO Type TRANSITE Dia. 16" 1.0 Slot/gauze 1/8" Length 39 1/2 Set between 2 ft. and 27 ft. _____ Fittings: 48 Gravel pack ☒ Yes ☐ No Size range of material 4"		
	Loam-Sand	0	2	9 Static water level: 24 ft. below land surface Date 10-27-15		
	Clay - Grey Dark	2	8	10 Pumping level below land surfaces: 54 ft. after 2 hrs. pumping 1100 g.p.m. _____ ft. after _____ hrs. pumping _____ g.p.m. Estimated maximum yield 1100 g.p.m.		
	SAND - MED - FINE	8	15	11 Water sample submitted: ☐ Yes ☒ No Date _____		
	SAND - MEDIUM-LOOSE	15	21	12 Well head completion: ☐ Pitless adapter ☐ Inches above grade		
	CLAY - BLUE	21	26	13 Well grouted? ☒ Yes ☐ No ☐ Neat cement ☐ Bentonite ☐ Puddled clay Depth: From 0 ft. to 12 ft.		
	GRAVEL - COARSE	26	28	14 Nearest source of possible contamination: ft. 42 Direction SO Type CREEK Well disinfected upon completion? ☐ Yes ☒ No		
	SAND - FINE TO MED.	28	35	15 Pump: ☐ Not installed Manufacturer's name WESTERN LAND ROLLER Model number 8m HP 30 Volts 480 Length of drop pipe 70 ft. capacity 1100 g.p.m. Type: ☐ Submersible ☒ Turbine ☐ Jet ☐ Reciprocating ☐ Centrifugal ☐ Other		
	CLAY - DARK - HARD	35	87	16 Remarks: elevation Topography: FLAT LAND. ☐ Hill ☐ Slope ☐ Upland ☐ Valley		
				17 Water well contractor's certification: This well was drilled under my jurisdiction and this report is true to the best of my knowledge and belief. Peterson Bros Inc License No. 138 Address 600 x 150 LINCOLN Signed V. Peterson Date 11-25-15 Authorized representative		