


1 LOCATION OF WATER WELL: County: Harvey Fraction: NE 1/4 SW 1/4 NE 1/4 Section Number: 2 Township Number: 240 Range Number: 2 EW: 0

Distance and direction from nearest town or city street address of well if located within city? See below

2 WATER WELL OWNER: Miner Chappell
 RR#, St. Address, Box #: 300 E. 9th
 City, State, ZIP Code: Halstead KS 67056
 Board of Agriculture, Division of Water Resources
 Application Number:

3 LOCATE WELL'S LOCATION WITH AN "X" IN SECTION BOX:

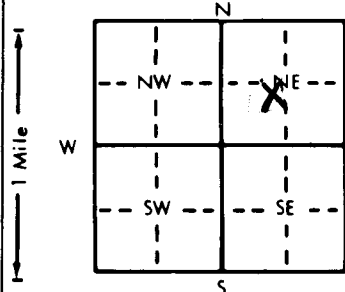

4 DEPTH OF COMPLETED WELL: 80 ft. ELEVATION:

Depth(s) Groundwater Encountered: 1. 23 ft. 2. 9-11-98 ft. 3. 9-11-98 ft.

WELL'S STATIC WATER LEVEL: 23 ft. below land surface measured on mo/day/yr 9-11-98

Pump test data: Well water was 20 gpm. Well water was 89 ft. after 11 hours pumping 89 gpm.

Est. Yield: 20 gpm. Well water was 89 ft. after 11 hours pumping 89 gpm.

Bore Hole Diameter: 11 in. to 89 ft., and 89 in. to 89 ft.

WELL WATER TO BE USED AS: 5 Public water supply 8 Air conditioning 11 Injection well
 1 Domestic 3 Feedlot 6 Oil field water supply 9 Dewatering 12 Other (Specify below)
 2 Irrigation 4 Industrial 7 Lawn and garden only 10 Monitoring well

Was a chemical/bacteriological sample submitted to Department? Yes X No X If yes, mo/day/yr sample was submitted

Water Well Disinfected? Yes X No X

5 TYPE OF BLANK CASING USED: 5 Wrought iron 8 Concrete tile CASING JOINTS: Glued X Clamped X

1 Steel 3 RMP (SR) 6 Asbestos-Cement 9 Other (specify below) Welded X

2 PVC 4 ABS 7 Fiberglass Threaded X

Blank casing diameter: 5 in. to 55 ft., Dia. 2.40 in. to 160 PSI

Casing height above land surface: 12 in., weight 2.40 lbs./ft. Wall thickness or gauge No. 160 PSI

TYPE OF SCREEN OR PERFORATION MATERIAL: 7 PVC 10 Asbestos-cement

1 Steel 3 Stainless steel 5 Fiberglass 8 RMP (SR) 11 Other (specify) 160 PSI

2 Brass 4 Galvanized steel 6 Concrete tile 9 ABS 12 None used (open hole)

SCREEN OR PERFORATION OPENINGS ARE: 5 Gauzed wrapped 8 Saw cut 11 None (open hole)

1 Continuous slot 3 Mill slot 6 Wire wrapped 9 Drilled holes

2 Louvered shutter 4 Key punched 7 Torch cut 10 Other (specify) 80

SCREEN-PERFORATED INTERVALS: From 55 ft. to 80 ft., From 23 ft. to 80 ft.

GRAVEL PACK INTERVALS: From 23 ft. to 80 ft., From 23 ft. to 80 ft.

6 GROUT MATERIAL: 3 1 Neat cement 230 2 Cement grout 3 Bentonite 4 Other 40

Grout Intervals: From 230 ft. to 40 ft., From 230 ft. to 40 ft., From 230 ft. to 40 ft.

What is the nearest source of possible contamination: 10 Livestock pens 14 Abandoned water well

1 Septic tank 4 Lateral lines 7 Pit privy 11 Fuel storage 15 Oil well/Gas well

2 Sewer lines 5 Cess pool 8 Sewage lagoon 12 Fertilizer storage 16 Other (specify below)

3 Watertight sewer lines 6 Seepage pit 9 Feedyard 13 Insecticide storage

Direction from well? North How many feet? 40

FROM TO LITHOLOGIC LOG FROM TO PLUGGING INTERVALS

0 31 clay

31 45 fine to med. sand

45 68 clay

68 80 fine sand

7 CONTRACTOR'S OR LANDOWNER'S CERTIFICATION: This water well was (1) constructed, (2) reconstructed, or (3) plugged under my jurisdiction and was completed on (mo/day/year) 9-17-98 and this record is true to the best of my knowledge and belief. Kansas

Water Well Contractor's License No. 318 This Water Well Record was completed on (mo/day/yr) 9-17-98

under the business name of Weninger Drilling Inc. by (signature) Nichelle Gorges