


1 LOCATION OF WATER WELL:	Fraction	Section Number	Township Number	Range Number
County: <i>Harvey</i>	<i>SW 1/4 SW 1/4 NE 1/4</i>	<i>2</i>	T <i>21</i> S	R <i>2</i> E

Distance and direction from nearest town or city street address of well if located within city?
1010 11th terrace in Halstead

2	WATER WELL OWNER:	Norman Janzon	
	RR#, St. Address, Box # :	1010 11 th Terrace	Board of Agriculture, Division of Water Resources
	City, State, ZIP Code :	Halstead, KS 67056	Application Number:

3 LOCATE WELL'S LOCATION WITH AN "X" IN SECTION BOX: 4 DEPTH OF COMPLETED WELL 109 ft. ELEVATION:

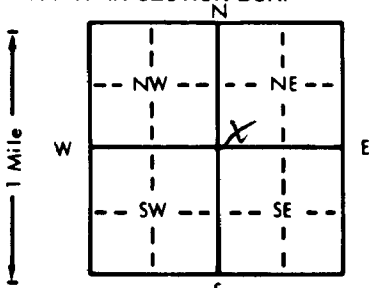

4 DEPTH OF COMPLETED WELL 109 ft. ELEVATION: _____
 Depth(s) Groundwater Encountered 1. _____ ft. 2. _____ ft. 3. _____ ft.
 WELL'S STATIC WATER LEVEL 23 ft. below land surface measured on mo/day/yr 3-26-98
 Pump test data: Well water was 33 ft. after 2 hours pumping 25 gpm
 Est. Yield _____ gpm: Well water was _____ ft. after _____ hours pumping _____ gpm
 Bore Hole Diameter 8 in. to 116 ft., and _____ in. to _____ ft.
 WELL WATER TO BE USED AS:
 1 Domestic 3 Feedlot 6 Oil field water supply 9 Dewatering 11 Injection well
 2 Irrigation 4 Industrial 7 Lawn and garden only 10 Monitoring well
 Was a chemical/bacteriological sample submitted to Department? Yes _____ No X _____; If yes, mo/day/yr sample was submitted _____
 Water Well Disinfected? Yes X No _____

5	TYPE OF BLANK CASING USED:			5 Wrought iron	8 Concrete tile	CASING JOINTS: Glued <input checked="" type="checkbox"/> Clamped Welded Threaded
	1 Steel	3 RMP (SR)	6 Asbestos-Cement	9 Other (specify below)		
	<input checked="" type="checkbox"/> PVC	4 ABS	7 Fiberglass			

Blank casing diameter 5 in. to 99 ft., Dia in. to ft., Dia in. to ft.

Casing height above land surface 12 in. weight 3.29 lbs./ft. Wall thickness or gauge No. 160

TYPE OF SCREEN OR PERFORATION MATERIAL:					7 PVC	10 Asbestos-cement
1 Steel	3 Stainless steel	5 Fiberglass	8 RMP (SR)	11 Other (specify)		
2 Brass	4 Galvanized steel	6 Concrete tile	9 ABS	12 None used (open hole)		

SCREEN OR PERFORATION OPENINGS ARE:

1 Continuous slot	3 Mill slot	5 Gauzed wrapped	8 Saw cut	11 None (open hole)
2 Louvered shutter	4 Key punched	6 Wire wrapped	9 Drilled holes	
		7 Torch cut	10 Other (specify)	

SCREEN-PERFORATED INTERVALS: From 99 ft. to 109 ft. From ft. to ft. From ft. to ft. From ft. to ft.

GRAVEL PACK INTERVALS: From 22 ft. to 75 ft., From 80 ft. to 111 ft.

6 GROUT MATERIAL:		1 Neat cement		2 Cement grout		3 Bentonite		4 Other	
Grout Intervals:	From	ft to	From	ft to	From	ft to	From	ft to	

What is the nearest source of possible contamination:

1 Septic tank	4 Lateral lines	7 Pit privy	10 Livestock pens	14 Abandoned water well
2 Sewer lines	5 Cess pool	8 Sewage lagoon	11 Fuel storage	15 Oil well/Gas well
3 Watertight sewer lines	6 Seepage pit	9 Feedyard	12 Fertilizer storage	16 Other (specify below)
			13 Insecticide storage	

[illegible]

7. CONTRACTOR'S OR LANDOWNER'S CERTIFICATION: This water well was (1) constructed, (2) reconstructed, or (3) plugged under my jurisdiction and was completed on (mo/day/year) 3-26-99 and this record is true to the best of my knowledge and belief. Kansas Water Well Contractor's License No. 447 This Water Well Record was completed on (mo/day/yr) 3-27-99 under the business name of Miller Drilling by (signature) E. Miller