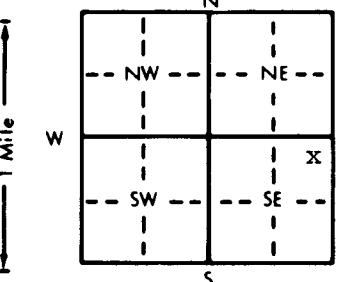


1) LOCATION OF WATER WELL:		Fraction	Section Number	Township Number	Range Number
County: Harvey		NE 1/4 NE 1/4 SE 1/4	16	T 24 S	R 2 E/W
Distance and direction from nearest town or city street address of well if located within city?					
Approximately 1 mile west and 2 1/2 miles south of Halstead					
2) WATER WELL OWNER:		City of Wichita			
RR#, St. Address, Box # :		455 N. Main			
City, State, ZIP Code :		Wichita, KS 67202			
		Board of Agriculture, Division of Water Resources			
		Application Number:			
3) LOCATE WELL'S LOCATION WITH AN "X" IN SECTION BOX:		4) DEPTH OF COMPLETED WELL... 41.10 ft. ELEVATION:			
		Depth(s) Groundwater Encountered 1. ft. 2. ft. 3. ft.			
		WELL'S STATIC WATER LEVEL ... 19 ft. below land surface measured on mo/day/yr ... 5-30-00			
		Pump test data: Well water was ft. after hours pumping gpm			
		Est. Yield gpm: Well water was ft. after hours pumping gpm			
		Bore Hole Diameter in. to ft., and in. to ft.			
		WELL WATER TO BE USED AS: 5 Public water supply 8 Air conditioning 11 Injection well			
		1 Domestic Was 3 Feedlot 6 Oil field water supply 9 Dewatering 12 Other (Specify below)			
		2 Irrigation 4 Industrial 7 Lawn and garden only 10 Monitoring well			
		Was a chemical/bacteriological sample submitted to Department? Yes.....No.....; If yes, mo/day/yr sample was submitted			
		Water Well Disinfected? Yes No			
5) TYPE OF BLANK CASING USED:		CASING JOINTS: Glued Clamped			
1 Steel 3 RMP (SR)		Welded			
2 PVC 4 ABS		Threaded			
Blank casing diameter . 2 in. to ft., Dia in. to ft., Dia in. to ft.					
Casing height above land surface . 4 ft. below in., weight lbs./ft. Wall thickness or gauge No.					
TYPE OF SCREEN OR PERFORATION MATERIAL:		7 PVC 10 Asbestos-cement			
1 Steel 3 Stainless steel 5 Fiberglass 8 RMP (SR) 11 Other (specify)					
2 Brass 4 Galvanized steel 6 Concrete tile 9 ABS 12 None used (open hole)					
SCREEN OR PERFORATION OPENINGS ARE:		5 Gauzed wrapped 8 Saw cut 11 None (open hole)			
1 Continuous slot 3 Mill slot 6 Wire wrapped 9 Drilled holes					
2 Louvered shutter 4 Key punched 7 Torch cut 10 Other (specify)					
SCREEN-PERFORATED INTERVALS: From ft. to ft., From ft. to ft., From ft. to ft.					
GRAVEL PACK INTERVALS: From ft. to ft., From ft. to ft., From ft. to ft.					
6) GROUT MATERIAL: 1 Neat cement 2 Cement grout 3 Bentonite 4 Other Bentonite Holeplug					
Grout Intervals: From ft. to ft., From ft. to ft., From ft. to ft.					
What is the nearest source of possible contamination:		10 Livestock pens 14 Abandoned water well			
1 Septic tank 4 Lateral lines 7 Pit privy 11 Fuel storage 15 Oil well/Gas well					
2 Sewer lines 5 Cess pool 8 Sewage lagoon 12 Fertilizer storage 16 Other (specify below)					
3 Watertight sewer lines 6 Seepage pit 9 Feedyard 13 Insecticide storage None known					
Direction from well?		How many feet?			
FROM	TO	LITHOLOGIC LOG	FROM	TO	PLUGGING INTERVALS
			41.1	4	Bentonite Holeplug
			4	0	Topsoil
7) CONTRACTOR'S OR LANDOWNER'S CERTIFICATION: This water well was (1) constructed, (2) reconstructed, or (3) plugged under my jurisdiction and was completed on (mo/day/year) 5-30-00 and this record is true to the best of my knowledge and belief. Kansas Water Well Contractor's License No. 185 This Water Well Record was completed on (mo/day/yr) 6-2-00 under the business name of Clarke Well & Equipment, Inc. by (signature)					

OFFICE USE ONLY

↑

五

EM

SEC.

 $\frac{1}{2}$

4

 $\frac{1}{2}$