76 5724

WATER WELL RECORD

Form WWC-5 KSA 82a-1212 ID No. IW-11A

1 LOCATION OF WATER WELL: County: Harvey | Fraction: NW 1/4 NW 1/4 SW 1/4 | Section Number: 3 | Township Number: T 24 S | Range Number: R 2 E (W)

Distance and direction from nearest town or city street address of well if located within city?

Approximately 1 mile west and 1/2 mile south of Halstead

2 WATER WELL OWNER: City of Wichita

RR#, St. Address, Box # : 455 N. Main

City, State, ZIP Code : Wichita, KS 67202

Board of Agriculture, Division of Water Resources Application Number:

3 LOCATE WELL'S LOCATION WITH AN "X" IN SECTION BOX:

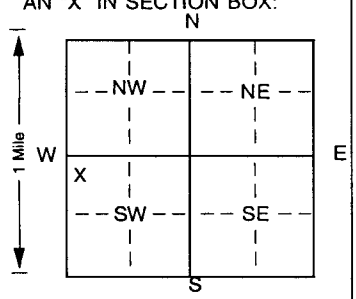

4 DEPTH OF COMPLETED WELL 25 ft. ELEVATION: unknown

Depth(s) Groundwater Encountered 1 ft. 2 ft. 3 ft.

WELL'S STATIC WATER LEVEL not checked ft. below land surface measured on mo/day/yr

Pump test data: Well water was not checked ft. after hours pumping gpm

Est. Yield unknown gpm: Well water was ft. after hours pumping gpm

Bore Hole Diameter 6 in. to 25 ft., and in. to ft.

WELL WATER TO BE USED AS: 1 Domestic 2 Irrigation 3 Feedlot 4 Industrial 5 Public water supply 6 Oil field water supply 7 Domestic (lawn & garden) 8 Air conditioning 9 Dewatering 10 Monitoring well 11 Injection well 12 Other (specify below) Index Well

Was a chemical/bacteriological sample submitted to Department? Yes No ✓ If yes, mo/day/yrs sample was submitted

Water Well Disinfected? Yes No ✓

5 TYPE OF BLANK CASING USED: 1 Steel 2 PVC (2) 3 RMP (SR) 4 ABS 5 Wrought iron 6 Asbestos-Cement 7 Fiberglass 8 Concrete tile 9 Other (specify below)

CASING JOINTS: Glued ✓ Clamped Welded Threaded

Blank casing diameter 2 in. to 13 ft., Dia in. to ft., Dia in. to ft

Casing height above land surface 24 in., weight .70 lbs./ft. Wall thickness or gauge No .154

TYPE OF SCREEN OR PERFORATION MATERIAL: 1 Steel 2 Brass 3 Stainless steel 4 Galvanized steel 5 Fiberglass 6 Concrete tile 7 PVC (7) 8 RMP (SR) 9 ABS 10 Asbestos-cement 11 Other (specify) 12 None used (open hole)

SCREEN OR PERFORATION OPENINGS ARE: 1 Continuous slot 2 Louvered shutter 3 Mill slot (3) 4 Key punched 5 Gauzed wrapped 6 Wire wrapped 7 Torch cut 8 Saw cut 9 Drilled holes 10 Other (specify) 11 None (open hole)

SCREEN-PERFORATED INTERVALS: From 13 ft. to 23 ft., From ft. to ft.

From ft. to ft., From ft. to ft.

GRAVEL PACK INTERVALS: From 9 ft. to 25 ft., From ft. to ft.

From ft. to ft., From ft. to ft.

6 GROUT MATERIAL: 1 Neat cement (1) 2 Cement grout 3 Bentonite 4 Other Bentonite Holeplug

Grout Intervals: From 0 ft. to 2 ft., From ft. to ft., From 2 ft. to 9 ft.

What is the nearest source of possible contamination:

1 Septic tank 2 Sewer lines 3 Watertight sewer lines 4 Lateral lines 5 Cess pool 6 Seepage pit 7 Pit privy 8 Sewage lagoon 9 Feedyard 10 Livestock pens 11 Fuel storage 12 Fertilizer storage 13 Insecticide storage 14 Abandoned water well 15 Oil well/Gas well 16 Other (specify below) None known

Direction from well? How many feet?

FROM	TO	LITHOLOGIC LOG	FROM	TO	PLUGGING INTERVALS
0	4	Topsoil			
4	14	Clay, dark brown			
14	15	Clay, tan, sandy			
15	18	Sand, fine, very fine			
18	25	Sand and gravel, medium, fine			

7 CONTRACTOR'S OR LANDOWNER'S CERTIFICATION: This water well was (1) constructed, (2) reconstructed, or (3) plugged under my jurisdiction and was completed on (mo/day/year) 7-2-01 and this record is true to the best of my knowledge and belief. Kansas Water Well Contractor's License No 185 This Water Well Record was completed on (mo/day/yr) 7-27-01 under the business name of Clarke Well & Equipment, Inc. by (signature)

INSTRUCTIONS: Use typewriter or ball point pen. *PLEASE PRESS FIRMLY* and *PRINT* clearly. Please fill in blanks, underline or circle the correct answers. Send top three copies to Kansas Department of Health and Environment, Bureau of Water, Topeka, Kansas 66620-0001. Telephone 785-296-5524. Send one to WATER WELL OWNER and retain one for your records. Fee of $5.00 for each constructed well.