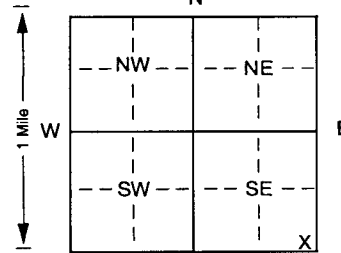


1 LOCATION OF WATER WELL:		Fraction		Section Number		Township Number		Range Number	
County: Harvey		SE 1/4 SE 1/4 SE 1/4		19		T 24 S		R 2 E	
Distance and direction from nearest town or city street address of well if located within city?									
Approximately 3 miles west and 4 miles south of Halstead									
2 WATER WELL OWNER: City of Wichita									
RR#, St. Address, Box # : 455 N. Main									
City, State, ZIP Code : Wichita, KS 67202									
Board of Agriculture, Division of Water Resources									
Application Number:									
3 LOCATE WELL'S LOCATION WITH AN "X" IN SECTION BOX:		4 DEPTH OF COMPLETED WELL 47 ft. ELEVATION: unknown							
		Depth(s) Groundwater Encountered 1 ft. 2 ft. 3 ft.							
		WELL'S STATIC WATER LEVEL not checked ft. below land surface measured on mo/day/yr							
		Pump test data: Well water was not checked ft. after hours pumping gpm							
		Est. Yield unknown gpm: Well water was ft. after hours pumping gpm							
		Bore Hole Diameter 6 in. to 47 ft., and in. to ft.							
		WELL WATER TO BE USED AS: 5 Public water supply 8 Air conditioning 11 Injection well							
		1 Domestic 3 Feedlot 6 Oil field water supply 9 Dewatering 12 Other (specify below)							
		2 Irrigation 4 Industrial 7 Domestic (lawn & garden) 10 Monitoring well Index Well							
		Was a chemical/bacteriological sample submitted to Department? Yes No If yes, mo/day/yr sample was submitted							
		Water Well Disinfected? Yes No							
5 TYPE OF BLANK CASING USED:									
1 Steel 3 RMP (SR) 5 Wrought iron 8 Concrete tile CASING JOINTS: Glued Clamped									
2 PVC 4 ABS 6 Asbestos-Cement 9 Other (specify below) Welded									
7 Fiberglass Threaded									
Blank casing diameter 2 in. to 25 ft., Dia in. to ft., Dia in. to ft.									
Casing height above land surface 24 in., weight .70 lbs./ft. Wall thickness or gauge No 154									
TYPE OF SCREEN OR PERFORATION MATERIAL:									
1 Steel 3 Stainless steel 5 Fiberglass 8 RMP (SR) 10 Asbestos-cement									
2 Brass 4 Galvanized steel 6 Concrete tile 9 ABS 11 Other (specify)									
12 None used (open hole)									
SCREEN OR PERFORATION OPENINGS ARE:									
1 Continuous slot 3 Mill slot 5 Gauzed wrapped 8 Saw cut 11 None (open hole)									
2 Louvered shutter 4 Key punched 6 Wire wrapped 9 Drilled holes									
3 Torch cut 10 Other (specify) ft.									
SCREEN-PERFORATED INTERVALS: From 25 ft. to 45 ft., From ft. to ft.									
GRAVEL PACK INTERVALS: From 19 ft. to 47 ft., From ft. to ft.									
6 GROUT MATERIAL: 1 Neat cement 2 Cement grout 3 Bentonite 4 Other Bentonite Holeplug									
Grout Intervals: From 0 ft. to 12 ft., From ft. to ft., From 12 ft. to 19 ft.									
What is the nearest source of possible contamination:									
1 Septic tank 4 Lateral lines 7 Pit privy 10 Livestock pens 14 Abandoned water well									
2 Sewer lines 5 Cess pool 8 Sewage lagoon 11 Fuel storage 15 Oil well/Gas well									
3 Watertight sewer lines 6 Seepage pit 9 Feedyard 12 Fertilizer storage 16 Other (specify below)									
13 Insecticide storage None known									
Direction from well? How many feet?									
FROM TO LITHOLOGIC LOG FROM TO PLUGGING INTERVALS									
0 4 Topsoil									
4 18 Clay, brown, sandy									
18 19 Clay, tan									
19 36 Sand and gravel, coarse, medium, fine									
36 37 Clay, tan and white									
37 47 Sand and gravel, coarse, medium, fine									
* NOT STANDARD WATER WELL CONSTRUCTION - USED AS INDEX WELL CITY OF WICHITA CHD # 2 & USGS									
7 CONTRACTOR'S OR LANDOWNER'S CERTIFICATION: This water well was (1) constructed (2) reconstructed or (3) plugged under my jurisdiction and was completed on (mo/day/year) 8-1-01 and this record is true to the best of my knowledge and belief. Kansas Water Well Contractor's License No 185 This Water Well Record was completed on (mo/day/yr) 8-23-01 under the business name of Clarke Well & Equipment, Inc. by (signature)									
INSTRUCTIONS: Use typewriter or ball point pen. PLEASE PRESS FIRMLY and PRINT clearly. Please fill in blanks, underline or circle the correct answers. Send top three copies to Kansas Department of Health and Environment, Bureau of Water, Topeka, Kansas 66620-0001. Telephone 785-296-5524. Send one to WATER WELL OWNER and retain one for your records. Fee of \$5.00 for each constructed well.									