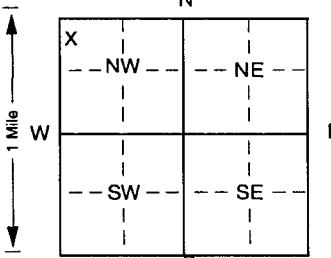


1 LOCATION OF WATER WELL:	Fraction	Section Number	Township Number	Range Number
County: Harvey	NW 1/4 NW 1/4 NW 1/4	1	T 24 S	R 2 E (W)

Distance and direction from nearest town or city street address of well if located within city?

Just east of Halstead

2 WATER WELL OWNER:	City of Wichita	Board of Agriculture, Division of Water Resources
RR#, St. Address, Box #	: 455 N. Main	Application Number:
City, State, ZIP Code	: Wichita, KS 67202	

3 LOCATE WELL'S LOCATION WITH AN "X" IN SECTION BOX:	4 DEPTH OF COMPLETED WELL 78 ft. ELEVATION: unknown
	Depth(s) Groundwater Encountered 1 ft. 2 ft. 3 ft. ft.
	WELL'S STATIC WATER LEVEL not checked ft. below land surface measured on mo/day/yr
	Pump test data: Well water was not checked ft. after hours pumping gpm
	Est. Yield unknown gpm: Well water was ft. after hours pumping gpm
	Bore Hole Diameter 6 in. to 120 ft., and in. to ft.
	WELL WATER TO BE USED AS: 5 Public water supply 8 Air conditioning 11 Injection well
	1 Domestic 3 Feedlot 6 Oil field water supply 9 Dewatering 12 Other (specify below)
	2 Irrigation 4 Industrial 7 Domestic (lawn & garden) 10 Monitoring well Index Well
	Was a chemical/bacteriological sample submitted to Department? Yes No <input checked="" type="checkbox"/> If yes, mo/day/yr sample was submitted
	Water Well Disinfected? Yes No <input checked="" type="checkbox"/>

5 TYPE OF BLANK CASING USED:	5 Wrought iron	8 Concrete tile	CASING JOINTS: Glued <input checked="" type="checkbox"/> Clamped	
1 Steel	3 RMP (SR)	6 Asbestos-Cement	9 Other (specify below)	Welded
2 PVC	4 ABS	7 Fiberglass		Threaded
Blank casing diameter 2 in. to 56 ft., Dia				in. to ft.
Casing height above land surface 24 in., weight .96 lbs./ft.				Wall thickness or gauge No .218
TYPE OF SCREEN OR PERFORATION MATERIAL:	7 PVC	10 Asbestos-cement		
1 Steel	3 Stainless steel	5 Fiberglass	8 RMP (SR)	11 Other (specify)
2 Brass	4 Galvanized steel	6 Concrete tile	9 ABS	12 None used (open hole)
SCREEN OR PERFORATION OPENINGS ARE:	5 Gauzed wrapped	8 Saw cut	11 None (open hole)	
1 Continuous slot	3 Mill slot	6 Wire wrapped	9 Drilled holes	
2 Louvered shutter	4 Key punched	7 Torch cut	10 Other (specify)	ft.
SCREEN-PERFORATED INTERVALS:	From 56 ft. to 76 ft., From			ft. to ft.
	From ft. to ft., From			ft. to ft.
GRAVEL PACK INTERVALS:	From 48 ft. to 76 ft., From			ft. to ft.
	From ft. to ft., From			ft. to ft.

6 GROUT MATERIAL:	1 Neat cement	2 Cement grout	3 Bentonite	4 Other 50% Sand and 50% Bentonite Holeplug
Grout Intervals: From 0 ft. to 37 ft., From 37 - 48 ft. to 76 - 82 ft., From 82 ft. to 120 ft.				
What is the nearest source of possible contamination:	1 Septic tank	4 Lateral lines	7 Pit privy	10 Livestock pens
	2 Sewer lines	5 Cess pool	8 Sewage lagoon	11 Fuel storage
	3 Watertight sewer lines	6 Seepage pit	9 Feedyard	12 Fertilizer storage
				13 Insecticide storage
				14 Abandoned water well
				15 Oil well/Gas well
				16 Other (specify below)
				None known
Direction from well?				How many feet?

FROM	TO	LITHOLOGIC LOG	FROM	TO	PLUGGING INTERVALS
0	5	Topsoil			
5	19	Clay, brownish gray			
19	32	Sand and gravel, medium, fine			
32	52	Clay, gray green, gravel streaks			
52	61	Clay, tan			
61	73	Sand, fine, very fine, clay streaks			
73	86	Sand and gravel, medium, fine, very fine			
86	89	Clay, tannish brown			
89	114	Sand and gravel, medium, fine			
114	116	Shale, weathered			
116	120	Shale, black			

7 CONTRACTOR'S OR LANDOWNER'S CERTIFICATION: This water well was (1) constructed (2) reconstructed, or (3) plugged under my jurisdiction and was completed on (mo/day/year) 9-13-01 and this record is true to the best of my knowledge and belief. Kansas Water Well Contractor's License No 185 This Water Well Record was completed on (mo/day/yr) 9-20-01 under the business name of Clarke Well & Equipment, Inc. by (signature) [Signature]
---

INSTRUCTIONS: Use typewriter or ball point pen. PLEASE PRESS FIRMLY and PRINT clearly. Please fill in blanks, underline or circle the correct answers. Send top three copies to Kansas Department of Health and Environment, Bureau of Water, Topeka, Kansas 66620-0001. Telephone 785-296-5524. Send one to WATER WELL OWNER and retain one for your records. Fee of \$5.00 for each constructed well.