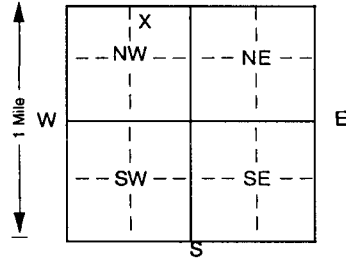


<b>1 LOCATION OF WATER WELL:</b>		Fraction		Section Number		Township Number		Range Number	
County: <b>Harvey</b>		NW 1/4 NE 1/4 NW 1/4		25		T 24 S		R 2 E <span style="border: 1px solid black; border-radius: 50%; padding: 2px;">W</span>	
Distance and direction from nearest town or city street address of well if located within city? Approximately 4 miles south and 1/4 mile east of Halstead	
<b>2 WATER WELL OWNER:</b> City of Wichita RR#, St. Address, Box # : 455 N. Main City, State, ZIP Code : Wichita, KS 67202 Board of Agriculture, Division of Water Resources Application Number:	
<b>3 LOCATE WELL'S LOCATION WITH AN "X" IN SECTION BOX:</b>		<b>4 DEPTH OF COMPLETED WELL</b> 137 ft. <b>ELEVATION:</b> unknown	
<div style="text-align: center;"></div>		Depth(s) Groundwater Encountered 1 ft. 2 ft. 3 ft. ft.	
		WELL'S STATIC WATER LEVEL not checked ft. below land surface measured on mo/day/yr	
		Pump test data: Well water was not checked ft. after hours pumping gpm	
		Est. Yield unknown gpm: Well water was ft. after hours pumping gpm	
		Bore Hole Diameter 6 in. to 180 ft., and in. to ft.	
WELL WATER TO BE USED AS: 1 Domestic 3 Feedlot 6 Oil field water supply 9 Dewatering 12 Other (specify below) 2 Irrigation 4 Industrial 7 Domestic (lawn & garden) 10 Monitoring well Index Well	
Was a chemical/bacteriological sample submitted to Department? Yes No <input checked="" type="checkbox"/> If yes, mo/day/yr sample was submitted Water Well Disinfected? Yes No <input checked="" type="checkbox"/>	
<b>5 TYPE OF BLANK CASING USED:</b> 1 Steel 3 RMP (SR) 5 Wrought iron 8 Concrete tile CASING JOINTS: Glued <input checked="" type="checkbox"/> Clamped 2 PVC 4 ABS 6 Asbestos-Cement 9 Other (specify below) Welded 7 Fiberglass Threaded Blank casing diameter 2 in. to 115 ft., Dia in. to ft., Dia in. to ft. Casing height above land surface 24 in., weight .96 lbs./ft. Wall thickness or gauge No .218	
TYPE OF SCREEN OR PERFORATION MATERIAL: 1 Steel 3 Stainless steel 5 Fiberglass 7 PVC 10 Asbestos-cement 2 Brass 4 Galvanized steel 6 Concrete tile 8 RMP (SR) 11 Other (specify) 12 None used (open hole)	
SCREEN OR PERFORATION OPENINGS ARE: 1 Continuous slot 3 Mill slot 5 Gauzed wrapped 8 Saw cut 11 None (open hole) 2 Louvered shutter 4 Key punched 6 Wire wrapped 9 Drilled holes 7 Torch cut 10 Other (specify) ft.	
SCREEN-PERFORATED INTERVALS: From 115 ft. to 135 ft., From ft. to ft. From ft. to ft., From ft. to ft. GRAVEL PACK INTERVALS: From 109 ft. to 143 ft., From ft. to ft. From ft. to ft., From ft. to ft.	
<b>6 GROUT MATERIAL:</b> 1 Neat cement 2 Cement grout 3 Bentonite Sand 4 Other Bentonite Holeplug Grout Intervals: From 0 ft. to 104 ft., From 148 ft. to 180 ft., From 104 - 109 ft. to 143 - 148 ft. What is the nearest source of possible contamination: 1 Septic tank 4 Lateral lines 7 Pit privy 10 Livestock pens 14 Abandoned water well 2 Sewer lines 5 Cess pool 8 Sewage lagoon 11 Fuel storage 15 Oil well/Gas well 3 Watertight sewer lines 6 Seepage pit 9 Feedyard 12 Fertilizer storage 16 Other (specify below) 13 Insecticide storage None known Direction from well? How many feet?	
<table border="1" style="width:100%; border-collapse: collapse;"><thead><tr><th>FROM</th><th>TO</th><th>LITHOLOGIC LOG</th><th>FROM</th><th>TO</th><th>PLUGGING INTERVALS</th></tr></thead><tbody><tr><td>0</td><td>4</td><td>Topsoil</td><td>169</td><td>170</td><td>Sand and gravel, medium, fine</td></tr><tr><td>4</td><td>12</td><td>Clay, tan</td><td>170</td><td>174</td><td>Shale, light green, weathered</td></tr><tr><td>12</td><td>54</td><td>Sand and gravel, coarse, medium, fine</td><td>174</td><td>180</td><td>Shale, black</td></tr><tr><td>54</td><td>56</td><td>Clay, green, gray</td><td></td><td></td><td></td></tr><tr><td>56</td><td>66</td><td>Sand and gravel, medium, fine</td><td></td><td></td><td></td></tr><tr><td>66</td><td>71</td><td>Clay, green and tan</td><td></td><td></td><td></td></tr><tr><td>71</td><td>83</td><td>Clay, tan and gray</td><td></td><td></td><td></td></tr><tr><td>83</td><td>93</td><td>Sand and gravel, medium, fine</td><td></td><td></td><td></td></tr><tr><td>93</td><td>97</td><td>Clay, tannish brown</td><td></td><td></td><td></td></tr><tr><td>97</td><td>130</td><td>Sand, medium, fine, very fine</td><td></td><td></td><td></td></tr><tr><td>130</td><td>137</td><td>Sand and gravel, medium, fine</td><td></td><td></td><td></td></tr><tr><td>137</td><td>141</td><td>Clay, gray, green</td><td></td><td></td><td></td></tr><tr><td>141</td><td>155</td><td>Clay, tannish brown</td><td></td><td></td><td></td></tr><tr><td>155</td><td>169</td><td>Sand, fine, very fine</td><td></td><td></td><td></td></tr>
<b>7 CONTRACTOR'S OR LANDOWNER'S CERTIFICATION:</b> This water well was (1) constructed (2) reconstructed , or (3) plugged under my jurisdiction and was completed on (mo/day/year) 10-18-01 and this record is true to the best of my knowledge and belief. Kansas Water Well Contractor's License No 185 This Water Well Record was completed on (mo/day/yr) 10-23-01 under the business name of Clarke Well & Equipment, Inc. by (signature) <i>Clarke Well &amp; Equipment, Inc.</i>	
INSTRUCTIONS: Use typewriter or ball point pen. PLEASE PRESS FIRMLY and PRINT clearly. Please fill in blanks, underline or circle the correct answers. Send top three copies to Kansas Department of Health and Environment, Bureau of Water, Topeka, Kansas 66620-0001. Telephone 785-296-5524. Send one to WATER WELL OWNER and retain one for your records. Fee of \$5.00 for each constructed well.	