

1 LOCATION OF WATER WELL:	Fraction	Section Number	Township Number	Range Number
County: Harvey	NW ¼ SW ¼ SW ¼	12	T 24 S	R 2 20 W


Distance and direction from nearest town or city street address of well if located within city?

2 miles South of Halstead, KS

2] WATER WELL OWNER : **Schwalter Foundation; c/o Willis Harder**
RR#, St. Address, Box # : **900 N. Poplar**
City, State, ZIP Code : **Newton, KS**

3	LOCATE WELL'S LOCATION WITH	4	DEPTH OF COMPLETED WELL..... 119 ft. ELEVATION:.....
---	-----------------------------	---	---

AN "X" IN SECTION BOX: Depth(s) Groundwater Encountered 1. ft. 2. ft. 3. ft.
WELL'S STATIC WATER LEVEL 22. ft. below land surface measured on mo/day/yr 10/25/01

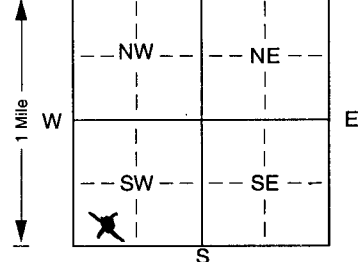

Pump test data: Well water was ft. after hours pumping gpm
 Est. Yield gpm: Well water was ft. after hours pumping gpm
 Bore Hole Diameter. . . . **30** . . . in. to . . . **119** . . . ft., and in. to ft.
 WELL WATER TO BE USED AS: 5 Public water supply 8 Air conditioning 11 Injection well
 1 Domestic 3 Feedlot 6 Oil field water supply 9 Dewatering 12 Other (Specify below)
 X Irrigation 4 Industrial 7 Domestic (lawn & garden) 10 Monitoring well
 Was a chemical/bacteriological sample submitted to Department? Yes. No. **X** ; If yes, mo/day/yr sample was submitted
 Water Well Disinfected? Yes **X** No

5	TYPE OF BLANK CASING USED:	5 Wrought iron	8 Concrete tile	CASING JOINTS: Glued. Clamped.
---	----------------------------	----------------	-----------------	--

1 Steel	3 RMP (SR)	6 Asbestos-Cement	9 Other (specify below)	Welded
2 PVC	4 ABS	7 Fiberglass		Threaded

Blank casing diameter . **1.6** . . . in. to . **59** . . . ft, Dia . . . in. to . . . ft, Dia . . . in. to . . . ft.
Casing height above land surface. **12** . . . in., weight **16.15** . . . lbs./ft. Wall thickness or gauge No. . **500**

TYPE OF SCREEN OR PERFORATION MATERIAL: ☒ PVC 10 Asbestos-cement

1 Steel	3 Stainless steel	5 Fiberglass	8 RMP (SR)	11 Other (specify)
2 Brass	4 Galvanized steel	6 Concrete tile	9 ABS	12 None used (open hole)

SCREEN OR PERFORATION OPENINGS ARE: 5 Gauzed wrapped 8 Saw cut 11 None (open hole)

1 Continuous slot	☒ Mill slot	6 Wire wrapped	9 Drilled holes
2 Louvered shutter	4 Key punched	7 Torch cut	10 Other (specify) ft.

SCREEN-PERFORATED INTERVALS: From 59 ft. to 119 ft., From _____ ft. to _____ ft.

From..... ft. to ft., From ft. to ft.

GRAVEL PACK INTERVALS: From **34** ft. to **119** ft., From ft. to ft.
From ft. to ft., From ft. to ft.

c. GROUT MATERIAL:				
1 Neat cement	2 Cement grout	3 Bentonite	4 Other	

Grout Intervals: From 5 ft. to 34 ft. From _____ ft. to _____ ft. From _____ ft. to _____ ft.

What is the nearest source of possible contamination: **None within 1/4 mile** 10 Livestock pens 14 Abandoned water well

1 Septic tank	4 Lateral lines	7 Pit privy	11 Fuel storage	15 Oil well/Gas well
2 Sewer lines	5 Cess pool	8 Sewage lagoon	12 Fertilizer storage	16 Other (specify below)

3 Watertight sewer lines	6 Seepage pit	9 Feedyard	13 Insecticide storage	
--------------------------	---------------	------------	------------------------	-------

Direction from well? _____ How many feet? _____

[illegible]

7 CONTRACTOR'S OR LANDOWNER'S CERTIFICATION: This water well was (☒ constructed, (2) reconstructed, or (3) plugged under my jurisdiction and was completed on (mo/day/year) **10/26/01** and this record is true to the best of my knowledge and belief. Kansas Water Well Contractor's Licence No. **138** This Water Well Record was completed on (mo/day/yr) **10/31/01** under the business name of **Peterson Irrigation, Inc.** by (signature) *Mike Peterson*