

1 LOCATION OF WATER WELL:	Fraction	Section Number	Township Number	Range Number
County: Harvey	SW $\frac{1}{4}$ SE $\frac{1}{4}$ NW $\frac{1}{4}$	23	T 24 S	R 2 XX W


Distance and direction from nearest town or city street address of well if located within city?

3 1/2 miles South of Halstead, KS2 WATER WELL OWNER: **John Stutzman**RR#, St. Address, Box # : **7415 S. Hertzler Rd.**City, State, ZIP Code : **Halstead, KS 67056**

Board of Agriculture, Division of Water Resources

Application Number: **12880**3 LOCATE WELL'S LOCATION WITH 4 DEPTH OF COMPLETED WELL. **101** ft. ELEVATION:

AN "X" IN SECTION BOX:

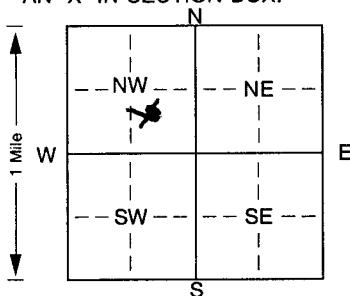

Depth(s) Groundwater Encountered 1. ft. 2. ft. 3. ft.

WELL'S STATIC WATER LEVEL **21** ft. below land surface measured on mo/day/yr **7/9/02**

Pump test data: Well water was ft. after hours pumping gpm

Est. Yield **800** gpm: Well water was ft. after hours pumping gpmBore Hole Diameter. **30** in. to **101** ft., and in. to ft.WELL WATER TO BE USED AS: 5 Public water supply 8 Air conditioning 11 Injection well
1 Domestic 3 Feedlot 6 Oil field water supply 9 Dewatering 12 Other (Specify below)☒ Irrigation 4 Industrial 7 Domestic (lawn & garden) 10 Monitoring wellWas a chemical/bacteriological sample submitted to Department? Yes. No. ☒ If yes, mo/day/yr sample was submitted
Water Well Disinfected? Yes ☒ No5 TYPE OF BLANK CASING USED: 5 Wrought iron 8 Concrete tile CASING JOINTS: Glued. ☒ Clamped.1 Steel 3 RMP (SR) 6 Asbestos-Cement 9 Other (specify below) Welded
☒ PVC 4 ABS 7 Fiberglass Threaded.Blank casing diameter **16** in. to **41** ft., Dia in. to ft., Dia in. to ft.Casing height above land surface. **12** in., weight **16.15** lbs./ft. Wall thickness or gauge No. **500**

TYPE OF SCREEN OR PERFORATION MATERIAL:

1 Steel 3 Stainless steel 5 Fiberglass ☒ PVC 10 Asbestos-cement
2 Brass 4 Galvanized steel 6 Concrete tile 8 RMP (SR) 11 Other (specify)
9 ABS 12 None used (open hole)

SCREEN OR PERFORATION OPENINGS ARE:

1 Continuous slot 3 Mill slot 5 Gauzed wrapped 8 Saw cut 11 None (open hole)
2 Louvered shutter 4 Key punched 6 Wire wrapped 9 Drilled holes
7 Torch cut 10 Other (specify) ft.SCREEN-PERFORATED INTERVALS: From. **41** ft. to **101** ft., From ft. to ft.
From. ft. to ft., From ft. to ft.GRAVEL PACK INTERVALS: From. **27** ft. to **101** ft., From ft. to ft.
From. ft. to ft., From ft. to ft.6 GROUT MATERIAL: 1 Neat cement ☒ Cement grout 3 Bentonite 4 OtherGrout Intervals: From. **0** ft. to **27** ft., From ft. to ft., From ft. to ft.

What is the nearest source of possible contamination:

1 Septic tank 4 Lateral lines 7 Pit privy 10 Livestock pens 14 Abandoned water well
2 Sewer lines 5 Cess pool 8 Sewage lagoon 11 Fuel storage 15 Oil well/Gas well
3 Watertight sewer lines 6 Seepage pit 9 Feedyard 12 Fertilizer storage 16 Other (specify below)
13 Insecticide storage **old irrigation**

Direction from well?

SoutheastHow many feet? **50** **well**

FROM	TO	LITHOLOGIC LOG	FROM	TO	PLUGGING INTERVALS
0	2	Topsoil			
2	8	Clay, sandy, brown			
8	15	Cemented gravel			
15	34	Coarse sand and gravel			
34	40	Sand, very fine with clay			
40	52	Sand, medium to coarse			
52	54	Clay, gray, sandy			
54	75	Sand, fine to Coarse, gray			
75	81	Clay, gray, sandy			
81	96	Sand, fine, gray			
96	99	Sand, medium			
99	101	Clay, green			

7 CONTRACTOR'S OR LANDOWNER'S CERTIFICATION: This water well was ☒ constructed, (2) reconstructed, or (3) plugged under my jurisdiction and wascompleted on (mo/day/year) **7/9/02** and this record is true to the best of my knowledge and belief. KansasWater Well Contractor's Licence No. **138** This Water Well Record was completed on (mo/day/yr) **7/10/02**under the business name of **Peterson Irrigation, Inc.**by (signature) *Mike Peterson*