

1	LOCATION OF WATER WELL:	Fraction	Section	Number	Township	Number	Range	Number
	County: HARVEY	SW $\frac{1}{4}$ SW $\frac{1}{4}$ SW $\frac{1}{4}$	14		24S		2W	E/W


Distance and direction from nearest town or city street address of well if located within city?

515' NORTH AND 5242' WEST OF THE APPARENT SOUTHEAST CORNER OF SECTION 14

2 WATER WELL OWNER: JOHN STUTZMAN

RR #, St. Address, Box #: 7415 S. HERTZLER RD
City, State, ZIP Code : HALSTEAD, KS 67056Board of Agriculture, Division of Water Resources
Application Number: 15803

3 MARK WELL'S LOCATION WITH AN "X" IN SECTION BOX:

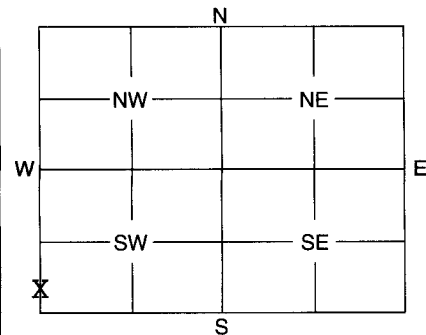

4 DEPTH OF WELL 76 ft.

WELL'S STATIC WATER LEVEL 22.9 ft.

WELL WAS USED AS:

1 Domestic

2 Irrigation

3 Feedlot

4 Industrial

5 Public Water Supply

6 Oil Field Water Supply

7 Domestic (Lawn & Garden)

8 Air Conditioning

9 Dewatering

10 Monitoring Well

11 Injection Well

12 Other

Was a chemical / bacteriological sample submitted to Department? Yes No ...X.....
If yes, mo/day/yr sample was submitted

Water Well Disinfected: Yes No ...X.....

5 TYPE OF BLANK CASING USED:

1 Steel

3 RMP (SR)

5 Wrought

7 Fiberglass

9 Other (Specify below)

2 PVC

4 ABS

6 Asbestos-Cement

8 Concrete Tile

Blank casing diameter 16 in. Was casing pulled? Yes No ...X..... If yes, how much

Casing height ~~20~~ or below land surface 36 in.6 GROUT PLUG MATERIAL: 1 Neat cement 2 Cement grout 3 Bentonite 4 Other
Grout Plug Intervals: From 23 ft. to 3 ft., From ft. to ft., From to ft.

What is the nearest source of possible contamination:

1 Septic tank

6 Seepage pit

11 Fuel storage

16 Other (specify below)

2 Sewer lines

7 Pit privy

12 Fertilizer storage

3 Watertight sewer lines

8 Sewage lagoon

13 Insecticide storage

4 Lateral lines

9 Feedyard

14 Abandoned water well

5 Cess pool

10 Livestock pens

15 Oil well/Gas well

Direction from well? NORTHEAST How many feet? 2000

FROM	TO	PLUGGING MATERIALS
76	23	COARSE SAND & GRAVEL
23	3	CEMENT GROUT
3	0	TOPSOIL

WELL PLUGGING WITNESSED BY
GROUNDWATER MANAGEMENT DISTRICT #2
STAFF.

7 CONTRACTOR'S OF LANDOWNER'S CERTIFICATION: This water well was plugged under my jurisdiction and was completed on (mo/day/year) 8/4/3 and this record is true to the best of my knowledge and belief. Kansas Water Well Contractor's License No. N/A This Water Well Record was completed on (mo/day/year) 11/6/03 under the business name of N/A by (signature) John Stutzman

INSTRUCTIONS: Use typewriter or ball point pen. Please press firmly and print clearly. Please fill in blanks, underline or circle the correct answers. Send top three copies to Kansas Department of Health and Environment, Bureau of Water, Geology Section, 1000 SW Jackson St., Ste. 420, Topeka, Kansas 66612-1367. Telephone: 785/296-5522. Send one to Water Well Owner and retain one for your records.