

1 LOCATION OF WATER WELL: Fraction SW 1/4 NE 1/4 NE 1/4 Section Number 5 Township Number T 24 S Range Number R 2 E
 County: Harvey

Distance and direction from nearest town or city street address of well if located within city? 1203 Chestnut - Halstead


2 WATER WELL OWNER: Steve Howard

RR#, St. Address, Box # :
 City, State, ZIP Code :

Board of Agriculture, Division of Water Resources
 Application Number:

3 LOCATE WELL'S LOCATION WITH AN "X" IN SECTION BOX:

4 DEPTH OF COMPLETED WELL 113 ft. ELEVATION:

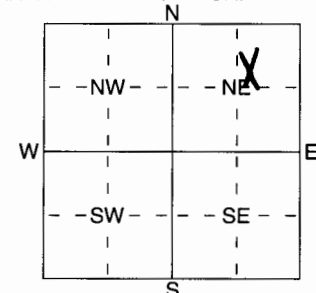

Depth(s) Groundwater Encountered 1 ft. 2 ft. 3 9-7-01 ft.
 WELL'S STATIC WATER LEVEL 21 ft. below land surface measured on mo/day/yr
 Pump test data: Well water was ft. after hours pumping gpm
 Est. Yield 20 gpm: Well water was ft. after hours pumping gpm
 WELL WATER TO BE USED AS: 5 Public water supply 8 Air conditioning 11 Injection well
 1 Domestic 3 Feedlot 6 Oil field water supply 9 Dewatering 12 Other (Specify below)
 2 Irrigation 4 Industrial (7) Domestic (lawn & garden) 10 Monitoring well

Was a chemical/bacteriological sample submitted to Department? Yes No X If yes, mo/day/yr sample was submitted
 Water Well Disinfected? Yes X No

5 TYPE OF BLANK CASING USED:

1 Steel 3 RMP (SR)
 2 PVC 4 ABS

5 Wrought iron 8 Concrete tile
 6 Asbestos-Cement 9 Other (specify below)
 7 Fiberglass

CASING JOINTS: Glued X Clamped
 Welded
 Threaded

Blank casing diameter 5 in. to 103 ft. Dia 8.40 in. to ft. Dia in. to ft.
 Casing height above land surface 12 in. weight 160 lbs/ft lbs./ft. Wall thickness or gauge No. 160 psi

TYPE OF SCREEN OR PERFORATION MATERIAL:

1 Steel 3 Stainless Steel 5 Fiberglass
 2 Brass 4 Galvanized Steel 6 Concrete tile

7 PVC 10 Asbestos-Cement
 8 RMP (SR) 11 Other (Specify)
 9 ABS 12 None used (open hole)

SCREEN OR PERFORATION OPENINGS ARE:

1 Continuous slot 3 Mill slot
 2 Louvered shutter 4 Key punched

5 Guazed wrapped 8 Saw cut 11 None (open hole)
 6 Wire wrapped 9 Drilled holes
 7 Torch cut 10 Other (specify) ft.

SCREEN-PERFORATED INTERVALS: From 103 ft. to 113 ft. From ft. to ft.
 From 21 ft. to 113 ft. From ft. to ft.
 GRAVEL PACK INTERVALS: From 21 ft. to 113 ft. From ft. to ft.
 From ft. to ft. From ft. to ft.

6 GROUT MATERIAL: 1 Neat cement 2 Cement grout 3 Bentonite 4 Other

Grout Intervals: From 3 ft. to 21 ft. From ft. to ft. From ft. to ft.

What is the nearest source of possible contamination:

1 Septic tank 4 Lateral lines 7 Pit privy 10 Livestock pens 14 Abandoned water well
 2 Sewer lines 5 Cess pool 8 Sewage lagoon 11 Fuel storage 15 Oil well/Gas well
 3 Watertight sewer lines 6 Seepage pit 9 Feedyard 12 Fertilizer storage 16 Other (specify below)
 13 Insecticide storage

Direction from well? West How many feet? 20

FROM	TO	LITHOLOGIC LOG	FROM	TO	PLUGGING INTERVALS
0	1	top soil			
1	15	fine sand			
15	20	clay			
20	30	med sand			
30	75	clay			
75	113	fine sand			

RECEIVED

OCT 04 2004

BUREAU OF WATER

7 CONTRACTOR'S OR LANDOWNER'S CERTIFICATION: This water well was (1) constructed, (2) reconstructed, or (3) plugged under my jurisdiction and was completed on (mo/day/year) 9-7-04 and this record is true to the best of my knowledge and belief. Kansas Water Well Contractor's Licence No. 318 This Water Well Record was completed on (mo/day/yr) 9-8-04 under the business name of Weninger Drilling Inc. by (signature) Michael Rogers