

CORRECTION(S) TO WATER WELL RECORD (WWC-5)

(to rectify lacking or incorrect information)

Location listed as:

Section-Township-Range: 2-24 S-2 WFraction ($\frac{1}{4}$ $\frac{1}{4}$ $\frac{1}{4}$): NW NE NECounty: Harvey

Location changed to:

2-24 S-2 WNE NE NW

Other changes: Initial statements: _____

Changed to: _____

Comments: _____

verification method: Well address, city street map, mapping tool
on KGS website, and original construction records
for these wells. initials: DRD date: 8/25/2006

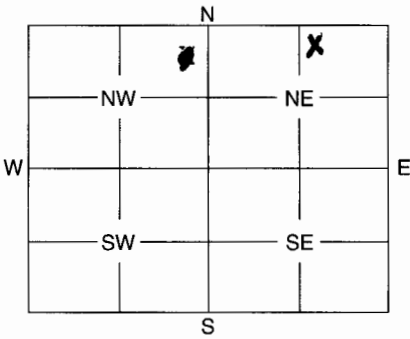
submitted by: Kansas Geological Survey, Data Resources Library, 1930 Constant Ave., Lawrence, KS 66047-3726
to: Kansas Dept of Health & Environment, Bureau of Water, 1000 SW Jackson, Suite 420, Topeka, KS 66612-1367.

1	LOCATION OF WATER WELL:	Fraction	Section	Number	Township	Number	Range	Number
	County: <u>Harvey</u>	$\frac{1}{4}$ NW $\frac{1}{4}$ NE $\frac{1}{4}$ NE	2		24 S		2	EW

Distance and direction from nearest town or city street address of well if located within city?

520 W 6th St - Halstead, KS

2	WATER WELL OWNER: <u>USD 440</u>	RR #, St. Address, Box #: <u>520 W 6th ST</u>	Board of Agriculture, Division of Water Resources
	City, State, ZIP Code : <u>Halstead, KS 67056</u>	Application Number:	

3	MARK WELL'S LOCATION WITH AN "X" IN SECTION BOX:	4	DEPTH OF WELL <u>24.48</u> ft.
			WELL'S STATIC WATER LEVEL <u>11.64</u> ft.
			WELL WAS USED AS:
			1 Domestic 5 Public Water Supply 9 Dewatering 2 Irrigation 6 Oil Field Water Supply 10 Monitoring Well 3 Feedlot 7 Domestic (Lawn & Garden) 11 Injection Well 4 Industrial 8 Air Conditioning 12 Other
			Was a chemical / bacteriological sample submitted to Department? Yes No <u>X</u>
			If yes, mo/day/yr sample was submitted
			Water Well Disinfected: Yes No <u>X</u>

5	TYPE OF BLANK CASING USED:
	1 Steel 3 RMP (SR) 5 Wrought 7 Fiberglass 9 Other (Specify below) 2 PVC 4 ABS 6 Asbestos-Cement 8 Concrete Tile
	Blank casing diameter <u>2</u> in. Was casing pulled? Yes ☒ No If yes, how much <u>All</u>
	Casing height above or below land surface <u>-2</u> in.

6	GROUT PLUG MATERIAL:	1 Neat cement 2 Cement grout 3 Bentonite 4 Other
	GROUT PLUG INTERVALS: From <u>2.0</u> ft. to <u>0</u> ft., From ft. to ft., From ft. to ft.	
	What is the nearest source of possible contamination:	
	1 Septic tank 6 Seepage pit 11 Fuel storage 16 Other (specify below) 2 Sewer lines 7 Pit privy 12 Fertilizer storage 3 Watertight sewer lines 8 Sewage lagoon 13 Insecticide storage 4 Lateral lines 9 Feedyard 14 Abandoned water well 5 Cess pool 10 Livestock pens 15 Oil well/Gas well	
	Direction from well? <u>Due West</u> How many feet? <u>within 200</u>	

FROM	TO	PLUGGING MATERIALS
20	0	Bentonite

7	CONTRACTOR'S OF LANDOWNER'S CERTIFICATION: This water well was plugged under my jurisdiction and was completed on (mo/day/year) <u>6/7/05</u> and this record is true to the best of my knowledge and belief. Kansas Water Well Contractor's License No. <u>665</u> This Water Well Record was completed on (mo/day/year) <u>6/10/05</u> under the business name of <u>Pratt Well Environmental</u>
	by (signature) <u>Steven Egan</u>

INSTRUCTIONS: Use typewriter or ball point pen. Please press firmly and print clearly. Please fill in blanks, underline or circle the correct answers. Send top three copies to Kansas Department of Health and Environment, Bureau of Water, Geology Section, 1000 SW Jackson St., Ste. 420, Topeka, Kansas 66612-1367. Telephone: 785/296-5522. Send one to Water Well Owner and retain one for your records.