

LOCATION OF WATER WELL: HARVEY	Fraction NC-W side- NW ¼	Section Number 35	Township Number 24 SOUTH	Range Number 02 WEST
-----------------------------------	-----------------------------	----------------------	-----------------------------	-------------------------

Distance and direction from nearest town or city street address of well if located within city?

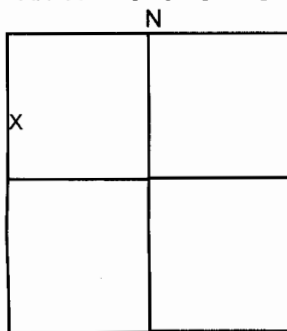
APPROXIMATELY 4.75 MILES SOUTH OF HALSTEAD, KS

WATER WELL OWNER:

RR#, St. Address, Box #: RICHARD BECKER
12619 SW 84TH ST.
HALSTEAD, KS 67056

Board of Agriculture, Division of Water Resources
Application Number: 24255

City, State, ZIP Code:

MARK WELL'S LOCATION WITH
AN "X" IN SECTION BOX

DEPTH OF WELL 87 ft.

WELL'S STATIC WATER LEVEL 22 ft.

WELL WAS USED AS:

- | | | |
|---------------------|--------------------------|--------------------|
| 1 Domestic | 5 Public Water Supply | 9 Dewatering |
| <u>2 Irrigation</u> | 6 Oil Field Water Supply | 10 Monitoring Well |
| 3 Feedlot | 7 Lawn and Garden Only | 11 Injection Well |
| 4 Industrial | 8 Air Conditioning | 12 Other |

Was a chemical/bacteriological sample submitted to Department? Yes ☐ No ☒

If yes, mo/day/yr sample was submitted : / /

Water Well Disinfected: Yes ☒ No ☐

TYPE OF BLANK CASING USED:

- | | | | | |
|---------|------------|--------------------------|-----------------|---------|
| 1 Steel | 3 RMP (SR) | 5 Wrought | 7 Fiberglass | 9 Other |
| 2 PVC | 4 ABS | <u>6 Asbestos-Cement</u> | 8 Concrete Tile | |

Blank casing diameter 16.0 in. Was casing pulled? Yes ☐ No ☒ if yes, how much 0.0 ft bls

Casing height above or below land surface 4 feet.

GROUT PLUG MATERIAL: 1 Neat cement 2 Cement grout 3 Bentonite 4 Other

Grout Plug Intervals: From 22 ft. to 4 ft.

What is the nearest source of possible contamination:

- | | | | |
|--------------------------|-------------------|-------------------------|----------|
| 1 Septic tank | 6 Seepage pit | <u>11 Fuel Storage</u> | 16 Other |
| 2 Sewer lines | 7 Pit privy | 12 Fertilizer storage | |
| 3 Watertight sewer lines | 8 Sewage lagoon | 13 Insecticide storage | |
| 4 Lateral lines | 9 Feedyard | 14 Abandoned water well | |
| 5 Cess Pool | 10 Livestock pens | 15 Oil well / Gas well | |

Direction from well?

East

How many feet? approximately 21 ft.

FROM	TO	PLUGGING MATERIALS
87	53	Formation Sand (Casing Collapsed)
53	22	Clean, Course Gravel
22	4	Cement Grout
4	3	Bentonite Hole Plug
3	0	Topsoil

WELL PLUGGING WITNESSED BY
EBGMD2 STAFF ON 6/7/10, 6/8/10, and
6/10/10

CONTRACTOR'S OR LANDOWNER'S CERTIFICATION: This water well was plugged under my jurisdiction and was completed on (mo/day/year) 6 / 10 / 2010 and this record is true to the best of my knowledge and belief.

Kansas Water Well Contractor's License No. NA under the business name of
by (signature) Richard L. Becker Richard Becker, owner

INSTRUCTIONS: Use typewriter or ball point pen. Please press firmly and print clearly. Please fill in blanks, and underline or circle the correct answers. Send top three copies to Kansas Department of Health and Environment, Bureau of Safe Drinking Water, Kansas 66620-0001. Telephone: 913/296-3565. Send one to Water Well Owner and retain one for your records.

RECEIVED

JUN 23 2010