

WATER WELL PLUGGING RECORD Form WWC-5P

KSA 82a-1212 ID NO.

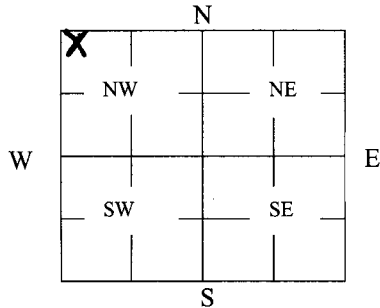
1 LOCATION OF WATER WELL: County: <u>Harvey</u>	Fraction <u>NW 1/4 NW 1/4 NW 1/4</u>	Section Number <u>23</u>	Township Number <u>24S</u>	Range Number <u>2</u> E/W <u>(W)</u>
--	---	-----------------------------	-------------------------------	---

Distance and direction from nearest town or city street address of well if located within city?

3 miles south of Halstead

2 WATER WELL OWNER: <u>John Stutzman</u> RR#, St. Address, Box #: <u>229 Chestnut St.</u> City, State ZIP Code: <u>Halstead, KS 67056</u>	Global Positioning Systems (decimal degrees, min. of 4 digits) Latitude: _____ Longitude: _____ Elevation: _____ Datum: _____ Data Collection Method: _____
---	--

3 MARK WELL'S LOCATION WITH AN "X" IN SECTION BOX:

4 DEPTH OF WELL 72 ft.WELL'S STATIC WATER LEVEL 19 ft.

WELL WAS USED AS:

- 1 Domestic
2 Irrigation
3 Feedlot
4 Industrial

- 5 Public Water Supply
6 Oil Field Water Supply
7 Domestic (Lawn & Garden)
8 Air Conditioning

- 9 Dewatering
10 Monitoring
11 Injection Well
12 Other _____

Was a chemical/bacteriological sample submitted to Department? Yes _____ No X

5 TYPE OF BLANK CASING USED:

- 1 Steel 3 RMP (SR) 5 Wrought 7 Fiberglass 9 Other (Specify below)
2 PVC 4 ABS 6 Asbestos-Cement 8 Concrete Tile

Blank casing diameter 16 in. Was casing pulled? Yes X No _____ If yes, how much 5'
Casing height above or below land surface 5' in.

6 GROUT PLUG MATERIAL: 1 Neat cement 2 Cement grout 3 Bentonite 4 Other _____

Grout Plug Intervals: From 5 ft. to 25 ft., From _____ ft. to _____ ft., From _____ to _____ ft.

What is the nearest source of possible contamination:

- 1 Septic tank 6 Seepage pit 11 Fuel Storage
2 Sewer lines 7 Pit privy 12 Fertilizer storage
3 Watertight sewer lines 8 Sewage lagoon 13 Insecticide storage
4 Lateral lines 9 Feedyard 14 Abandoned water well
5 Cess pool 10 Livestock pens 15 Oil well/Gas well

16 Other (specify below)
none-open field
Direction from well? _____
How many feet? _____

FROM	TO	PLUGGING MATERIALS	FROM	TO	PLUGGING MATERIALS
<u>0</u>	<u>5</u>	<u>Top Soil</u>			
<u>5</u>	<u>25</u>	<u>Cement</u>			
<u>25</u>	<u>72</u>	<u>Sand</u>			

7 CONTRACTOR'S OR LANDOWNER'S CERTIFICATION: This water well was plugged under my jurisdiction and was completed on (mo/day/year) 12/23/10 and this record is true to the best of my knowledge and belief. Kansas Water Well Contractor's License No. 238. This Water Well Record was completed on (mo/day/year) 12/27/10 under the business name of Premier Pump & Well Service by (signature) Patricia A. Allen

INSTRUCTIONS: Use typewriter or ballpoint pen. Please press firmly and print clearly. Please fill in blanks, underline or circle the correct answers. Send top three copies to Kansas Department of Health and Environment, Bureau of Water, Geology Section, 1000 SW Jackson St., Ste. 420, Topeka, Kansas 66612-1367. Telephone: 785/296-5522. Send one to Water Well Owner and retain one for your records. Visit us at <http://www.kdheks.gov/geo/waterwells>.