

WATER WELL PLUGGING RECORD Form WWC-5P

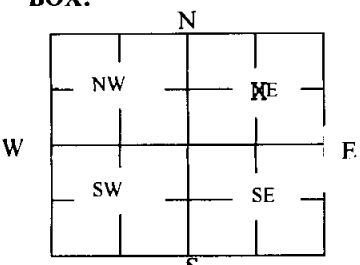
29666, 29667, 33578, 33579
KSA 82a-1212 ID NO.

1 LOCATION OF WATER WELL: County: Harvey	Fraction 1/4 1/4 NC 1/4 NE 1/4	Section Number 18	Township Number T 24 S	Range Number 2 ☐ E ☒ W
---	-----------------------------------	----------------------	---------------------------	--

Street/Rural Address of Well Location; if unknown, distance & direction from nearest town or intersection: If at owner's address, check here ☐ Approximately 3.25 miles west and 2.25 miles south of Halstead, KS

2 WATER WELL OWNER: Karl F. Krauss
RR#, St. Address, Box #: 7517 S. Springlake Rd.
City, State ZIP Code: Halstead, KS 67056

Global Positioning Systems (GPS) information:
Latitude: 37.96682 (in decimal degrees)
Longitude: -97.57807 (in decimal degrees)
Elevation:
Datum: ☐ WGS84, ☐ NAD83, ☒ NAD27
Collection Method:
☒ GPS unit (Make/Model: Garmin GPSmap 60CSx)
☐ Digital Map/Photo, ☐ Topographic Map, ☐ Land Survey
Est. Accuracy: ☐ < 3 m, ☒ 3-5 m, ☐ 5-15 m, ☐ > 15 m

3 MARK WELL'S LOCATION WITH AN "X" IN SECTION BOX: 	4 DEPTH OF WELL 130 ft. WELL'S STATIC WATER LEVEL 30.8 ft. WELL WAS USED AS: ☐ Domestic ☒ Irrigation ☐ Feedlot ☐ Industrial ☐ Public Water Supply ☐ Oil Field Water Supply ☐ Domestic (Lawn & Garden) ☐ Air Conditioning ☐ Dewatering ☐ Monitoring ☐ Injection Well ☐ Other Was a chemical/bacteriological sample submitted to Department? Yes ☐ No ☒
--	--

5 TYPE OF BLANK CASING USED:
☐ Steel ☐ RMP (SR) ☐ Wrought ☐ Fiberglass ☐ Other (Specify below)
☐ PVC ☐ ABS ☒ Asbestos-Cement ☐ Concrete Tile

Blank casing diameter 16 in. Was casing pulled? Yes ☐ No ☒ If yes, how much _____
Casing height above or below land surface below 36 in.

6 GROUT PLUG MATERIAL: ☐ Neat cement ☒ Cement grout ☐ Bentonite ☐ Other _____

Grout Plug Intervals: From 30.8 ft. to 3 ft., From 130 ft. to 30.8 ft., From _____ to _____ ft.

What is the nearest source of possible contamination:
☐ Septic tank ☐ Seepage pit ☒ Fuel Storage ☐ Other (specify below)
☐ Sewer lines ☐ Pit privy ☐ Fertilizer storage
☐ Watertight sewer lines ☐ Sewage lagoon ☐ Insecticide storage
☐ Lateral lines ☐ Feedyard ☐ Abandoned water well Direction from well? North
☐ Cess pool ☐ Livestock pens ☐ Oil well/Gas well How many feet? approximately 10 ft.

FROM	TO	PLUGGING MATERIALS	FROM	TO	PLUGGING MATERIALS
130	30.8	Clean, coarse sand			The 16 in. cased well is lined by a
30.8	3	Cement grout			12 in. pvc casing. Both casings
3	0	Topsoil			were removed 3 ft. below land
					surface and a 31 ft. deep open
		Well plugging witnessed by			space between the two casings was
		D. Randolph, GMD2 staff, on			plugged with cement grout.
		3-15-13 and 3-18-13.			

7 CONTRACTOR'S OR LANDOWNER'S CERTIFICATION: This water well was plugged under my jurisdiction and was completed on (mo/day/year) 3-18-2013 and this record is true to the best of my knowledge and belief. Kansas Water Well Contractor's License No. _____ This Water Well Record was completed on (mo/day/year) 3-25-2013 under the business name of Tri K Farms by (signature) [Signature]

INSTRUCTIONS: Use typewriter or ballpoint pen. Please press firmly and print clearly. Please fill in blanks, underline or circle the correct answers. Send top three copies to Kansas Department of Health and Environment, Bureau of Water, Geology Section, 1000 SW Jackson St., Ste. 420, Topeka, Kansas 66612-1367. Telephone: 785/296-5524. Send one to Water Well Owner and retain records. Visit us at <http://www.kdheks.gov/waterwell/index.html>.

Check one: ☐ White Copy ☐ Blue Copy ☐ Pink Copy

RECEIVED

APR 02 2013

Equus Beds Groundwater Management District No. 2