


WATER WELL RECORD Form WWC-5 KSA 82a-1212

1 LOCATION OF WATER WELL: Fraction Section Number Township Number Range Number
 COUNTY: 042 HODGEMAN SE 1/4 SE 1/4 SE 1/4 16 T T24 S R 21 W

Distance and direction from nearest town or city street address of well if located within city?
 1 MILE EAST, 5 1/2 MI. NORTH, 1 EAST OF BELFONTE

2 WATER WELL OWNER: W.C. BURKE 009 Board of Agriculture, Division of Water Resources
 RR#, St. Address, Box #: 1306 CLEVELAND
 City, State, ZIP code: GREAT BEND, KS 67530- Application Number:

3 LOCATE WELL'S LOCATION WITH AN "X" IN SECTION BOX:

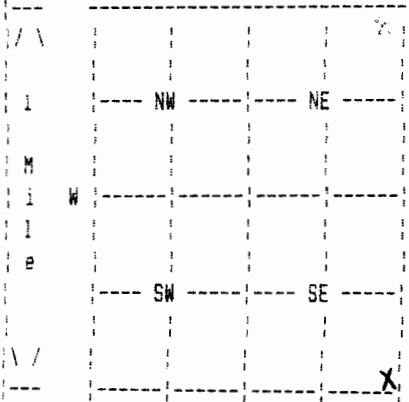

4 DEPTH OF COMPLETED WELL 120 ELEVATION:
 Depth(s) Groundwater Encountered 1. 63 ft. 2. ft. 3. ft.

WELL'S STATIC WATER LEVEL 63 ft. below land surface measured on mo/day/yr 4 /22/91
 Pump test data: Well water was ft. after hours pumping gpm

Estimated Yield gpm: Well water was ft. after hours pumping gpm

Bore Hole Diameter 4 in. to 120 ft., and in. to ft.

WELL WATER TO BE USED AS: 01 DOMESTIC

Was a chemical/bacteriological sample submitted to department? No ;
 If yes, mo/day/yr sample was submitted Water well disinfected? Yes

5 TYPE OF BLANK CASING USED: 01 STEEL CASING JOINTS: THREADED
 Blank casing diameter 4 in. to 120 ft., Dia in. to ft., Dia in. to ft.
 Casing height above land surface in., weight lbs/ft. Wall thickness or gauge No.
 TYPE OF SCREEN OR PERFORATION MATERIAL: 01 STEEL
 SCREEN OR PERFORATION OPENINGS ARE: 07 TORCH CUT

SCREEN PERFORATED INTERVALS: From ft. to ft., From ft. to ft.
 From ft. to ft., From ft. to ft.
 GRAVEL PACK INTERVALS: From 120 ft. to 65 ft., From ft. to ft.
 From ft. to ft., From ft. to ft.

6 GROUT MATERIAL 03 BENTONITE
 Grout Intervals: From 65 ft. to 4 ft., From ft. to ft., From ft. to ft.
 What is the nearest source of possible contamination: 10 LIVEST. PENS
 Direction from well? AROUND How many feet?

FROM	TO	LITHOLOGIC LOG	FROM	TO	PLUGGING INTERVALS
			120	65	SAND
			65	4	BENTONITE
			4	3	CEMENT

7 CONTRACTOR'S OR LANDOWNER'S CERTIFICATION: This water well was Plugged under my jurisdiction and was completed on (mo/day/year) 4 /22/91 and this record is true to the best of my knowledge and belief, Kansas Water Well Contractor's License No. 224 This Water Well Record was completed on (mo/day/yr) 06/13/91 under the business name of CARL HAYSE WATER WELL SVC by (signature) Carl Hayse