


LOCATION OF WATER WELL:	Fraction	Section Number	Township Number	Range Number
County: <i>Hodgeman</i>	<i>NE 1/4 NE 1/4 SE 1/4</i>	<i>25</i>	<i>T 24 S</i>	<i>R 22 E/W</i>

4 miles north 2 west Belfast KS

Board of Agriculture, Division of Water Resources  
Application Number: \_\_\_\_\_

4 DEPTH OF COMPLETED WELL... 150 ..... ft. ELEVATION: .....  
23

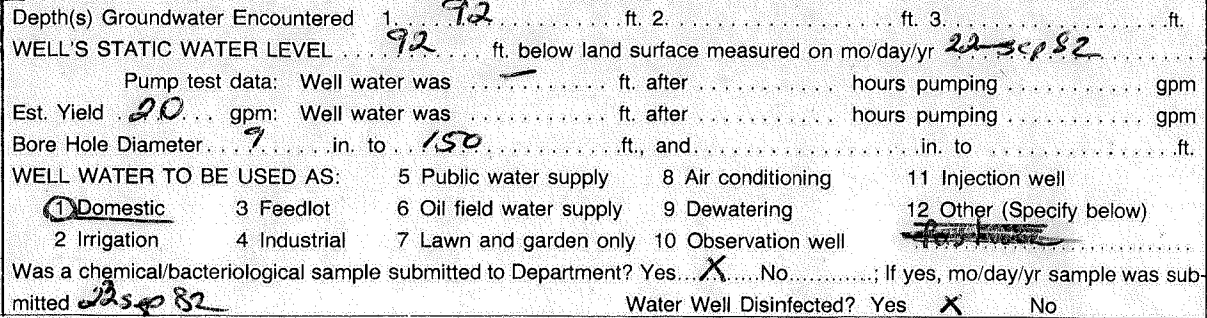

Blank casing diameter 5 in. to 120 ft. Dia. in. to ft. Dia. in. to ft.  
Casing height above land surface 12 in. weight 250 lbs./ft. Wall thickness or gauge No. 250

SCREEN OR PERFORATION OPENINGS ARE:

1 Continuous slot	3 Mill slot	5 Gauzed wrapped	8 Saw cut	11 None (open hole)
2 Louvered shutter	4 Key punched	6 Wire wrapped	9 Drilled holes	
		7 Torch cut	10 Other (specify) .....	

GRAVEL PACK INTERVALS: From 150 ft. to 10 ft., From \_\_\_\_\_ ft. to \_\_\_\_\_ ft.  
From \_\_\_\_\_ ft. to \_\_\_\_\_ ft., From \_\_\_\_\_ ft. to \_\_\_\_\_ ft.

What is the nearest source of possible contamination:

1 Septic tank	4 Lateral lines	7 Pit privy	<u>10</u> Livestock pens	14 Abandoned water well
2 Sewer lines	5 Cess pool	8 Sewage lagoon	11 Fuel storage	15 Oil well/Gas well
3 Watertight sewer lines	6 Seepage pit	9 Feedyard	12 Fertilizer storage	16 Other (specify below)
			13 Insecticide storage	

How many feet? 60

[illegible]

Water Well Contractor's License No. 111 This Water Well Record was completed on (mo/day/yr) 22 Sep 82  
under the business name of Craig DeLong by (signature) Craig DeLong

INSTRUCTIONS: Use typewriter or ball point pen, PLEASE PRESS FIRMLY and PRINT clearly. Please fill in blanks, underline or circle the correct answers. Send top three copies to Kansas Department of Health and Environment, Division of Environment, Environmental Geology Section, Topeka, KS 66620. Send one to WATER WELL OWNER and retain one for your records.