

1 LOCATION OF WATER WELL:		Fraction	Section Number	Township Number	Range Number
County:	<i>Hodgeman</i>	<i>SE</i> ¼ <i>SE</i> ¼ <i>SW</i> ¼	<i>33</i>	T <i>24</i> S	R <i>22</i> E <i>(W)</i>


Distance and direction from nearest town or city street address of well if located within city?

From Spearville 4 miles north then $\frac{1}{4}$ mile east

2 WATER WELL OWNER: Ed Durler
RR#, St. Address, Box # : Rt. 1 Box 40
City, State, ZIP Code : Spearville, Ks. 67876

Board of Agriculture, Division of Water Resources
Application Number:

3 LOCATE WELL'S LOCATION WITH AN "X" IN SECTION BOX: 4 DEPTH OF COMPLETED WELL: 170' ft. ELEVATION: _____

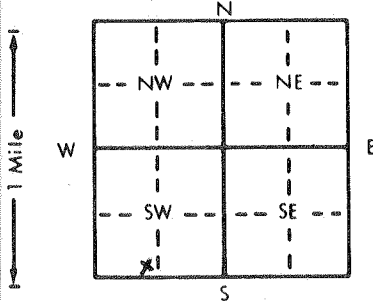

Depth(s) Groundwater Encountered ft. 2..... ft. 3.....

WELL'S STATIC WATER LEVEL 97' ft. below land surface measured on mo/day/yr 1-29-93

Pump test data: Well water was ft. after hours pumping gpm

Est. Yield gpm: Well water was ft. after hours pumping gpm

Bore Hole Diameter 9 7/8" in. to ft., and in. to ft.

WELL WATER TO BE USED AS:

5 Public water supply	8 Air conditioning	11 Injection well
1 Domestic	6 Oil field water supply	9 Dewatering
2 Irrigation	4 Industrial	10 Monitoring well
	7 Lawn and garden only	12 Other (Specify below)

Was a chemical/bacteriological sample submitted to Department? Yes.....No. X.....; If yes, mo/day/yr sample was submitted

Water Well Disinfected? Yes X No

5	TYPE OF BLANK CASING USED:		5 Wrought iron	8 Concrete tile	CASING JOINTS: Glued ☒ Clamped ☐ Welded ☐ Threaded ☐
	1 Steel	3 RMP (SR)	6 Asbestos-Cement	9 Other (specify below)	
	2 PVC	4 ABS	7 Fiberglass		

Blank casing diameter . . . 5" in. to . . . 150' ft., Dia . . . in. to . . . ft., Dia . . . in. to . . . ft.
Casing height above land surface . . . 2 1/2' in., weight . . . lbs./ft. Wall thickness or gauge No. . . SDR 21

TYPE OF SCREEN OR PERFORATION MATERIAL:

1 Steel	3 Stainless steel	5 Fiberglass	7 PVC	10 Asbestos-cement
2 Brass	4 Galvanized steel	6 Concrete tile	8 RMP (SR)	11 Other (specify)
			9 ABS	12 None used (open hole)

SCREEN OR PERFORATION OPENINGS ARE:

1 Continuous slot	3 Mill slot	5 Gauzed wrapped	8 Saw cut	11 None (open hole)
2 Louvered shutter	4 Key punched	6 Wire wrapped	9 Drilled holes	
		7 Torch cut	10 Other (specify)	

SCREEN-PERFORATED INTERVALS: From 150' ft. to 170' ft., From _____ ft. to _____ ft.
From _____ ft. to _____ ft., From _____ ft. to _____ ft.

GRAVEL PACK INTERVALS: From 20' ft. to 170' ft., From _____ ft. to _____ ft.
From _____ ft. to _____ ft., From _____ ft. to _____ ft.

6 GROUT MATERIAL: 1 Neat cement 2 Cement grout 3 Bentonite 4 Other
Grout Intervals: From 0 ft. to 10 ft. From ft. to ft. From ft. to ft.

What is the nearest source of possible contamination:

1 Septic tank	4 Lateral lines	7 Pit privy	10 <u>Livestock pens</u>	14 Abandoned water well
2 Sewer lines	5 Cess pool	8 Sewage lagoon	11 Fuel storage	15 Oil well/Gas well
3 Watertight sewer lines	6 Seepage pit	9 Feedyard	12 Fertilizer storage	16 Other (specify below)
			13 Insecticide storage	

Direction from well? On every side How many feet? 10'

[illegible]

7 CONTRACTOR'S OR LANDOWNER'S CERTIFICATION: This water well was (1) constructed, (2) reconstructed, or (3) plugged under my jurisdiction and was completed on (mo/day/year) 11-29-93 and this record is true to the best of my knowledge and belief. Kansas Water Well Contractor's License No. 553 This Water Well Record was completed on (mo/day/yr) 1-29-94 under the business name of Jantzen Water Well Repair by (signature) [Signature]